


M8  
5-23-63

WATER WELL DRILLERS LOG

Date: 5-23, 1963, Driller: McDonald & Theis

(Name)

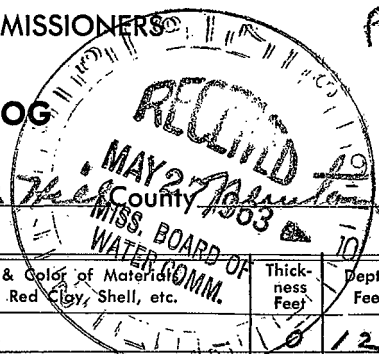

(1) Owner of Land: W F White  
(Name)  
(Address)

(2) Location: 1/4, 1/4, Sec. 2 T. R,  
5 miles North of Cheney,  
(distance) (direction) (Nearest Town)

(3) Topography: Hilly  
(Hilly) (Flat) (Level)

(4) Purpose of Well: Domestic  
(Domestic Irrigation  
Municipal, Industrial, Other)

Description & Color of Material Sand, Clay, Red Clay, Shell, etc.	Thick- ness Feet	Depth Feet
<u>Clay</u>	<u>10</u>	<u>12</u>
<u>lime shale &amp; lime</u>	<u>12</u>	<u>28</u>
<u>shale</u>	<u>28</u>	<u>152</u>
<u>sl. sup lime strata</u>	<u>152</u>	<u>160</u>
<u>of cl.</u>	<u>160</u>	<u>180</u>

Information upon completion of well:

(1) Diameter 4 inches.

(2) Total Depth 180 feet.

(3) Water Level 92 feet below top of ground.

(4) Cased to 146, Size 4"

(5) Screen: Size 2", Length 5"

(6) Were any formations sealed against pollution?  
           yes,            no.

If YES depth of formation \_\_\_\_\_

Why \_\_\_\_\_

Drillers Remarks: \_\_\_\_\_

(Use Back Side)

Well No.

