

Newton  
M 9  
5-14-69

MISSISSIPPI  
BOARD OF WATER COMMISSIONERS  
416 North State Street  
Jackson, Mississippi 39201

WATER WELL DRILLERS LOG

5-14-1969 date well completed  
Williamson Drilling firm name  
Newton county well located

LANDOWNER: Arthur Jensen  
Pt 1  
Chumby, Miss.  
(mailing address)

description of formations encountered	from	to
red Clay	0	8
red sand	8	30
Blue Clay	30	50
Green Clay & rock	50	220
White sand	220	265

WELL LOCATION:  
sec 15 T 6 N R 13 E  
3 miles N.W. of Chumby  
(distance) (direction) (nearest town)

WELL PURPOSE: Home  
(home, irrigation/municipal, industrial)

- WELL COMPLETION DATA:
- (1) diameter (inches) 4 1/2
  - (2) total depth (feet) 265
  - (3) static water level (feet) 120 below top of ground.
  - (4) casing Black (material) 162 (depth)  
4 (size) if telescope see back.
  - (5) screen no (length) (depth to top)  
(size) (material)
  - (6) pump 1/2 (HP) 10 (yield gpm)  
Elect (type power)
  - (7) electric log no (yes or no)  
no (organization running log)
  - (8) how well bottom plugged open


JUN 30 1969

MISS. BD. OF  
WATER COM.

DRILLERS REMARKS:

If well telescopes please sketch and show depths.

GROUND LEVEL

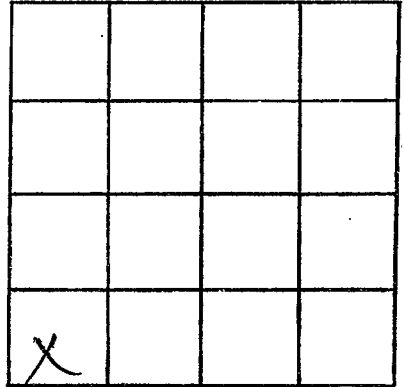

SECTION 15

Please indicate well location X.

ADDITIONAL INFORMATION

If more than one screen,  
show locations of each on sketch.