

M 11

7-26-63

WATER WELL DRILLERS LOG

Date: 7.26, 1963, Driller: McGraw & Hill County: _____
 (Name)

(1) Owner of Land: MC GREW
 (Name)
Chunky
 (Address)

(2) Location: 1/4, 1/4, Sec. 36 GN 13E T. R
 _____ miles _____ of _____
 (distance) (direction) (Nearest Town)

(3) Topography: X
 (Hilly) (Flat) (Level)

(4) Purpose of Well: DOMESTIC
 (Domestic Irrigation
 Municipal, Industrial, Other)

Description & Color of Materials Sand, Clay, Red. Clay, Shell, etc.	Thick- ness Feet	Depth Feet
<u>SANDY CLAY</u>	<u>0</u>	<u>25</u>
<u>SHALE</u>	<u>25</u>	<u>70</u>
<u>Rock ST SHALE</u>	<u>70</u>	<u>200</u>
<u>SHALE ST SAND</u>	<u>200</u>	<u>240</u>
<u>SAND 12.560T</u>	<u>240</u>	<u>270</u>

Information upon completion of well:

(1) Diameter 3 1/2 inches. TEST HOLE

(2) Total Depth 270' feet.


(3) Water Level 84' feet below top of ground.

(4) Cased to 252', Size 2"

(5) Screen: Size 2", Length 5' BRASS

(6) Were any formations sealed against pollution?
 _____ yes, _____ no.

If YES depth of formation _____
 Why _____
 Drillers Remarks: _____

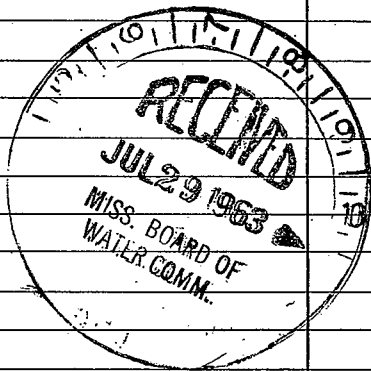

(Use Back Side)

Well No.

100

100

100

100