

M 13
7-29-63

WATER WELL DRILLERS LOG

Date: 7.29, 1963, Driller: McDaniel & Hill County _____
(Name)

(1) Owner of Land: MCCARTY
(Name)
Chunky Miss
(Address)

(2) Location: 1/4, 1/4, Sec. 36 ^{6N 13E} T. R.
_____ miles _____ of _____
(distance) (direction) (Nearest Town)

(3) Topography: X
(Hilly) (Flat) (Level)

(4) Purpose of Well: Domestic
(Domestic Irrigation
Municipal, Industrial, Other)

Description & Color of Materials Sand, Clay, Red Clay, Shell, etc.	Thick- ness Feet	Depth Feet
SAND	0	28
SHALE STRUCK	28	180
ROCK	180	240
FINE SAND	240	265
SAND	265	280

Information upon completion of well:

(1) Diameter 3 1/2 inches. TEST HOLE

(2) Total Depth 280 feet.

(3) Water Level 86' feet below top of ground.


(4) Cased to 273', Size 2"

(5) Screen: Size 2", Length 6'

(6) Were any formations sealed against pollution?
_____ yes, X no.

If YES depth of formation _____
Why _____

Drillers Remarks: _____

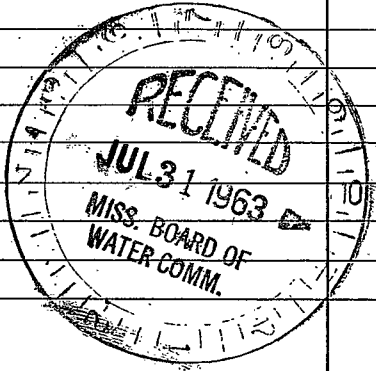

(Use Back Side)

Well No.

The first part of the document discusses the importance of maintaining accurate records of all transactions. It emphasizes that every entry, no matter how small, should be recorded to ensure the integrity of the financial statements. The text also mentions the need for regular audits to detect any discrepancies or errors in the accounting process.

In addition, the document highlights the role of the accounting department in providing valuable insights into the company's financial performance. By analyzing the data, accountants can identify trends, forecast future outcomes, and recommend strategies to improve profitability. This proactive approach is essential for long-term success in a competitive market.

Finally, the document stresses the importance of transparency and communication. All stakeholders, including management, investors, and creditors, should have access to clear and concise financial information. This transparency builds trust and ensures that everyone is on the same page regarding the company's financial health.

RECEIVED
 GENERAL INVESTMENT
 DEPARTMENT
 JAN 15 1964
 NEW YORK