

M15
11-11-63

WATER WELL DRILLERS LOG

P

Date: 11-11, 1963, Driller: Jerry County Newton
(Name)

- (1) Owner of Land: Mrs Chaney
(Name)
Chunky Miss.
(Address)
- (2) Location: 1/4, 1/4, Sec. 35 T6R13
15 miles west of Mdn
(distance) (direction) (Nearest Town)
- (3) Topography:
(Hilly) (Flat) (Level)
- (4) Purpose of Well: Domestic
(Domestic Irrigation
Municipal, Industrial, Other)

Description & Color of Materials Sand, Clay, Red Clay, Shell, etc.	Thick- ness Feet	Depth Feet
yellow slush	0	50
larger rock	50	150
sandy	150	189'


Information upon completion of well:

- (1) Diameter 3 inches.
- (2) Total Depth 189 feet.
- (3) Water Level 20 feet below top of ground.
- (4) Cased to 84', Size 3"
- (5) Screen: Size No, Length
- (6) Were any formations sealed against pollution?
yes, no.

If YES depth of formation 0-50 yellow sand

Why

Drillers Remarks: Casing set in rock formation

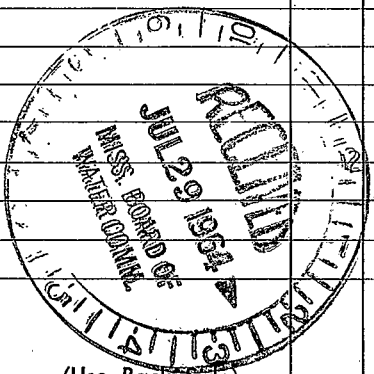

(Use Back Side)

Well No.

