

3 NEWTON
M 18
4-28-64

P

WATER WELL DRILLERS LOG

Date: 4-28, 1964, Driller: J. L. Wells County Newton
(Name)

(1) Owner of Land: L. Vance
(Name)
Cherby Miss
(Address)

(2) Location: SE 1/4, SE 1/4, Sec. 26 T. 6 R. 13
_____ miles _____ of _____
(distance) (direction) (Nearest Town)

(3) Topography: (Hilly) (Flat) (Level)

(4) Purpose of Well: Domestic
(Domestic Irrigation
Municipal, Industrial, Other)

Description & Color of Materials Sand, Clay, Red Clay, Shell, etc.	Thick- ness Feet	Depth Feet
<u>1/2 clay</u>	<u>16</u>	<u>0-16</u>
<u>B. Rocky</u>	<u>96</u>	<u>16-112</u>
<u>Sand</u>	<u>43</u>	<u>549</u>

Information upon completion of well:

(1) Diameter 4" inches.

(2) Total Depth 155 feet.

(3) Water Level 22 1/2 feet below top of ground.


(4) Cased to 21, Size 4"

(5) Screen: Size None Length _____

(6) Were any formations sealed against pollution?
_____ yes, _____ no.

If YES depth of formation _____
Why _____

Drillers Remarks: _____

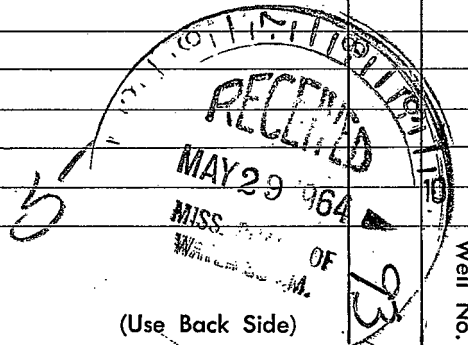

(Use Back Side)

