

M 21 Same as M 20

WATER WELL DRILLERS LOG

9-21-64

Date: 9-21, 1964, Driller: M. P. Donald & H. V. Inc County: newton

(Name)

(1) Owner of Land:	Description & Color of Materials Sand, Clay, Red Clay, Shell, etc.	Thick- ness Feet	Depth Feet
<u>Tommy Maxwell</u> (Name)	<u>CLAY</u>	<u>0</u>	<u>18</u>
<u>Chunky Miss</u> (Address)	<u>SHALE ST. ROCK</u>	<u>18</u>	<u>140</u>
	<u>SAND</u>	<u>140</u>	<u>160</u>
(2) Location: <u>1/4</u> , <u>1/4</u> , Sec. <u>36</u> <u>6N</u> <u>13E</u>			
<u>In Chunky</u> miles (distance) of (Nearest Town)			
(3) Topography: <u>✓</u> (Hilly) (Flat) (Level)			
(4) Purpose of Well: <u>DOMESTIC</u> (Domestic Irrigation Municipal, Industrial, Other)			


Information upon completion of well:

- (1) Diameter 3 3/8 TEST PIPE inches.
- (2) Total Depth 160' feet.
- (3) Water Level 42' feet below top of ground.
- (4) Cased to 47', Size 4" BLACK
- (5) Screen: Size _____, Length _____
- (6) Were any formations sealed against pollution?
_____ yes, _____ no.

If YES depth of formation _____

Why _____

Drillers Remarks: _____

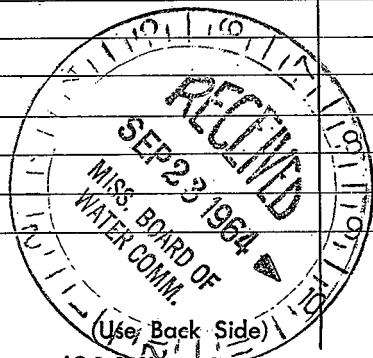

Well No.

