

62 AUD.
 M21
 3-12-63

WATER WELL DRILLERS LOG

P
 Newton?

Date: 8-12-1963, Driller: McDonald - Hill County Covington
 (Name)

(1) Owner of Land: John Smith
 (Name)
Chunky, Miss.
 (Address)

(2) Location: 1/4, 1/4, Sec. 3, T. 6N, R. 13E
12 miles W of Meridian
 (distance) (direction) (Nearest Town)

(3) Topography: ✓
 (Hilly) (Flat) (Level)

(4) Purpose of Well: Domestic
 (Domestic Irrigation, Municipal, Industrial, Other)

| Description & Color of Materials Sand, Clay, Red Clay, Shell, etc. | Thick- ness Feet | Depth Feet |
|---|------------------------|---------------|
| Clay | 0 | 25 |
| Shale | 25 | 30 |
| Sand | 30 | 35 |
| Shale | 35 | 43 |
| H. Shale | 43 | 59 |
| Shale - blue | 59 | 109 |
| Med. Shale | 109 | 173 |
| Sandy Shale | 173 | 179 |
| # 10 sand | 179 | 205 |
| Sand Shale | 205 | 215 |
| Med. Shale | 215 | 220 |

Information upon completion of well:

(1) Diameter 4 inches.

(2) Total Depth 220 feet.

(3) Water Level 63 feet below top of ground.


(4) Cased to 127, Size 4

(5) Screen: Size ✓, Length 5

(6) Were any formations sealed against pollution?
✓ yes, ✓ no.

If YES depth of formation _____
 Why _____

Drillers Remarks: _____

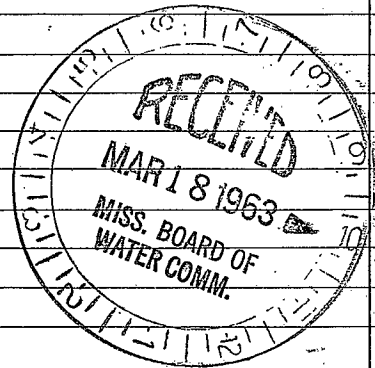

(Use Back Side)

Well No.

