

WATER WELL DRILLERS LOG

M22
9-21-64
Date: 9-21

Driller: M. E. Dornik & H. H. Fox
County: Newton
(Name)

(1) Owner of Land: REV GEMENY
 (Name)
Chunky Miss
 (Address)

(2) Location: 1/4, 1/4, Sec. 36 T. 6N R. 12E
1 miles (distance), N (direction), of Chunky (Nearest Town)

(3) Topography: V
 (Hilly) (Flat) (Level)

(4) Purpose of Well: DOMESTIC
 (Domestic Irrigation
 Municipal, Industrial, Other)

Description & Color of Materials Sand, Clay, Red Clay, Shell, etc.	Thick- ness Feet	Depth Feet
<u>CLAY</u>	<u>0</u>	<u>18'</u>
<u>SHALE STR ROCK</u>	<u>18</u>	<u>130</u>
<u>SAND</u>	<u>130</u>	<u>150</u>

Information upon completion of well:

(1) Diameter 3 7/8 inches. TEST HOLE


(2) Total Depth 150' feet.

(3) Water Level 40' feet below top of ground.

(4) Cased to 41', Size 4"

(5) Screen: Size _____, Length _____

(6) Were any formations sealed against pollution?
 _____ yes, _____ no.

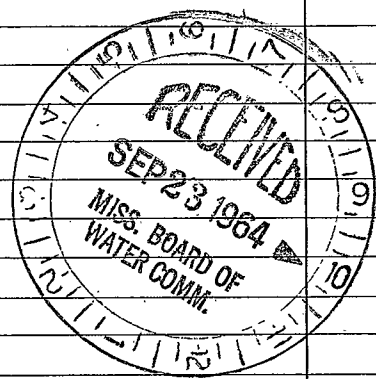

If YES depth of formation _____

Why _____

Drillers Remarks: _____

Well No.

(Use Back Side)

