

NEWTON
M23

WATER WELL DRILLERS LOG

P

Date: 11-6-64, 1964, Driller: M. E. Donald & Hill, Inc County Newton
(Name)

(1) Owner of Land: JAMES COLE
(Name)
Chunky Miss
(Address)

(2) Location: 1/4, 1/4, Sec. 36 GN 13E T. R.
_____ miles _____ of _____
(distance) (direction) (Nearest Town)

(3) Topography: X
(Hilly) (Flat) (Level)

(4) Purpose of Well: DOMESTIC
(Domestic Irrigation
Municipal, Industrial, Other)

Description & Color of Materials Sand, Clay, Red Clay, Shell, etc.	Thick- ness Feet	Depth Feet
<u>CLAY</u>	<u>0</u>	<u>20</u>
<u>SHALE</u>	<u>20</u>	<u>40</u>
<u>CLAY</u>	<u>40</u>	<u>60</u>
<u>SHALE ST @ SAND</u>	<u>120</u>	<u>190</u>
<u>SAND</u>	<u>190</u>	<u>210</u>

Information upon completion of well:

(1) Diameter 3/4 inches. TEST HOLE

(2) Total Depth 210' feet.

(3) Water Level 60' feet below top of ground.

(4) Cased to 84', Size 2" GALV
84' 3/8" PIPE (ROD)


(5) Screen: Size _____, Length _____

(6) Were any formations sealed against pollution?
_____ yes, _____ no.

If YES depth of formation 1- DEEP WELL HAND PUMP

Why 1- 2" LINE CYLINDER

Drillers Remarks: 1- 2" COUPLING
1- 3" X 2 BUSHING
1- 3" COUPLING

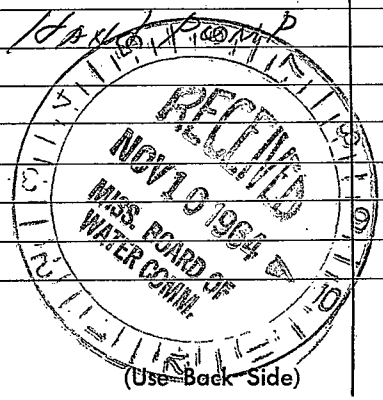

Well No.

...the ... of ...
...the ... of ...
