

6 NEWTON
M 26
2-26-66

WATER WELL DRILLERS LOG

P

Date: 2, 26, 1966, Driller: Mr. Donald J. Hill, Inc. County: Newton

(Name)

(1) Owner of Land: MRS GERTRUDE ALLEN
(Name)
Chunky
(Address)

(2) Location: 1/4, 1/4, Sec. 30 T. 13 E.
15' miles WEST of AMERICAN
(distance) (direction) (Nearest Town)

(3) Topography: _____
(Hilly) (Flat) (Level)

(4) Purpose of Well: Hilly
(Domestic Irrigation, Municipal, Industrial, Other)

Description & Color of Materials Sand, Clay, Red Clay, Shell, etc.	Thick- ness Feet	Depth, Feet
<u>CLAY</u>	<u>0</u>	<u>10</u>
<u>YELLOW CLAY SAND</u>	<u>10</u>	<u>40</u>
<u>BLUE SHALE</u>	<u>40</u>	<u>90</u>
<u>SHALE w/ Shells</u>	<u>90</u>	<u>115</u>
<u>SHALE ST ROCK</u>	<u>115</u>	<u>240</u>
<u>SAND</u>	<u>240</u>	<u>260</u>

Information upon completion of well:

(1) Diameter 3 3/4 inches. TEST HOLE

(2) Total Depth 260' feet.

(3) Water Level 135' feet below top of ground.


(4) Cased to 252, Size 2" GALV

(5) Screen: Size 2" BRASS, Length 10'

(6) Were any formations sealed against pollution?
_____ yes, _____ no.

If YES depth of formation _____
Why _____

Drillers Remarks: _____

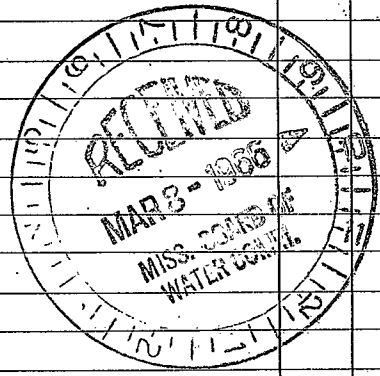

(Use Back Side)

Well No.

