

6 NEWTON

M 27

3-16-66

WATER WELL DRILLERS LOG

P

Date: 3-16, 1966, Driller: M. P. Donald & Hill Inc County Newton

(Name)

(1) Owner of Land: Chunky Bapt. Ch.
(Name)

Chunky Miss
(Address)

(2) Location: 1/4, 1/4, Sec 36 T R
IN Chunky

(distance) (direction) (Nearest Town)

(3) Topography: X
(Hilly) (Flat) (Level)

(4) Purpose of Well: DOMESTIC
(Domestic Irrigation
Municipal, Industrial, Other)

Description & Color of Materials
Sand, Clay, Red Clay, Shell, etc.

Thick-
ness
Feet

Depth
Feet

<u>CLAY ST SAND</u>	<u>0</u>	<u>17</u>
<u>ROCK</u>	<u>17</u>	<u>21</u>
<u>ROCK ST SAND</u>	<u>21</u>	<u>120</u>
<u>SAND</u>	<u>120</u>	<u>145</u>

Information upon completion of well:

(1) Diameter _____ inches.

(2) Total Depth 145' feet.

(3) Water Level 20' feet below top of ground.

(4) Cased to 43', Size 4"


(5) Screen: Size _____, Length _____

(6) Were any formations sealed against pollution?
_____ yes, X no.

If YES depth of formation _____

Why _____

Drillers Remarks: _____

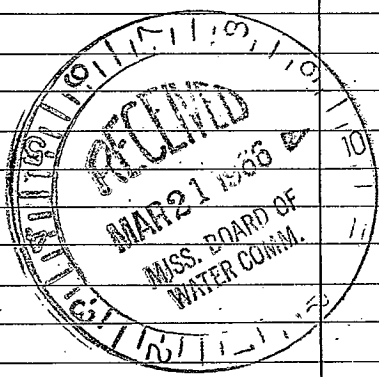

(Use Back Side)

Well No.

[The page contains extremely faint and illegible text, likely bleed-through from the reverse side of the document. No specific words or phrases can be discerned.]