

3 Newton
M29
12-66

P

MISSISSIPPI BOARD OF WATER COMMISSIONERS

WATER WELL DRILLERS LOG

Date: 12-12, 1966, Driller: M. E. Donald & H. Hill County Newton
 (When well drilled) (Name) (Where well is located)

(1) Owner of Land: T. E. JONES
 (Name)
CHUNKY MISS
 (Address)

(2) Location: NE 1/4, SE 1/4, Sec. 22, T. 6 R. 13, N E
3 miles WEST of Chunky
 (distance) (direction) (Nearest Town)

(3) Topography: X
 (Hilly) (Flat) (Level)

(4) Purpose of Well: DOMESTIC
 (Domestic Irrigation
 Municipal, Industrial, Other)

| Description & Color of Materials Sand, Clay, Red Clay, Shell, etc. | Thick- ness Feet | Depth Feet |
|---|------------------------|---------------|
| CLAY | 18 | 18 |
| SAND | 8 | 26 |
| SHALE | 44 | 70 |
| ROCK ST SHALE | 25 | 95 |
| SAND ST SHALE | 20 | 115 |
| ROCK ST SHALE | 85 | 200 |
| SHALE | 26 | 226 |
| SAND | 19 | 245 |

Information upon completion of well:

(1) Diameter 3 3/4 inches. ST. SHALE

(2) Total Depth 245' feet.

(3) Water Level 115' feet below top of ground.

(4) Cased to 240', Size 2"

(5) Screen: Size 2", Length 5'

(6) Were any formations sealed against pollution?
 _____ yes, _____ no.

If YES depth of formation _____


Why _____

Drillers Remarks: _____

Yield in gpm: 30

Size pump: _____

Type power: _____

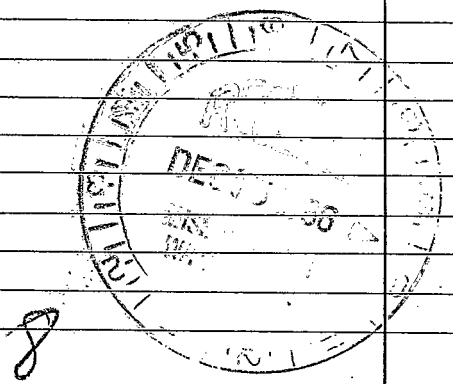

8

