

Newton
M30
8-67

MISSISSIPPI
 BOARD OF WATER COMMISSIONERS
 416 North State Street
 Jackson, Mississippi 39201

WATER WELL DRILLERS LOG

8.23.67 19 McDonald + Hill Newton
 date well completed firm name county well located

LANDOWNER: J.V. Emmsy
Chunky MISS
 (mailing address)

description of formations encountered	from	to
<u>Clay</u>	<u>0</u>	<u>18</u>
<u>Sand Rock ST Sand</u>	<u>18</u>	<u>40</u>
<u>SHALE</u>	<u>40</u>	<u>49</u>
<u>SHALE ST ROCK</u>	<u>49</u>	<u>165</u>
<u>Sand</u>	<u>165</u>	<u>180</u>


WELL LOCATION:
 sec. 22 T. 6 N R. 13 E
 S W
2 miles West of Chunky
 (distance) (direction) (nearest town)

WELL PURPOSE:
 (home, irrigation, municipal, industrial)

WELL COMPLETION DATA:


- (1) diameter (inches) 4" well
- (2) total depth (feet) 180'
- (3) static water level (feet) 44 below top of ground.
- (4) casing BLACK, 42'
 (material) (depth)
4" if telescope see back.
 (size)
- (5) screen NO, NO
 (length) (depth to top)
NO, NO
 (size) (material)
- (6) pump 1/2 JET, 10
 (HP) (yield gpm)
220
 (type power)
- (7) electric log NO
 (yes or no)
NO
 (organization running log)
- (8) how well bottom plugged OPEN

DRILLERS REMARKS:

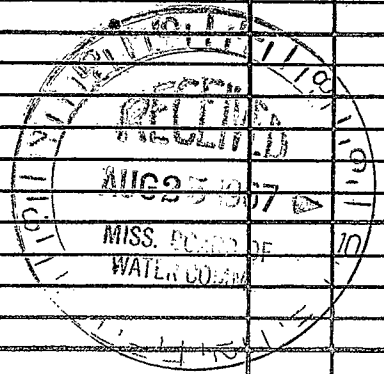

If well telescopes please sketch and show depths.

GROUND LEVEL

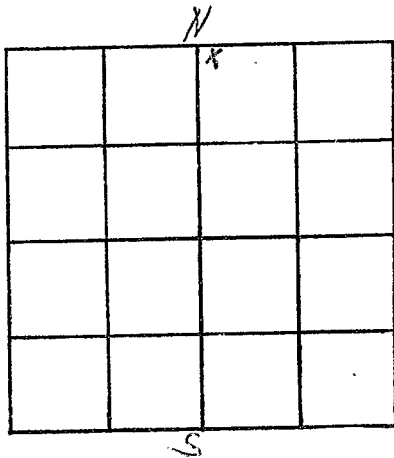

SECTION 22

Please indicate well location X.

ADDITIONAL INFORMATION

If more than one screen, show locations of each on sketch.