

L.A.U.D.

LM 32
4-18-64

WATER WELL DRILLERS LOG

Newton?

Date: 4-18, 1964, Driller: McDonald Hill County: Leflore
(Name)

(1) Owner of Land: Willie Craft
(Name)

Rt 2 Box 35 Chunky
(Address)

(2) Location: 1/4, 1/4, Sec. 36 LN 130
T R

1.2 miles WEST of Maudlin
(distance) (direction) (Nearest Town)

(3) Topography: X
(Hilly) (Flat) (Level)

(4) Purpose of Well: Domestic
(Domestic Irrigation
Municipal, Industrial, Other)

Description & Color of Materials Sand, Clay, Red Clay, Shell, etc.	Thick- ness Feet	Depth Feet
SAND	0	33
Rock ST SHALE	33	140
SHALE	140	165
SAND	165	210

Information upon completion of well:

(1) Diameter: 3 7/8 inches. Test Hole

(2) Total Depth: 210' feet.

(3) Water Level: 7' feet below top of ground.

(4) Cased to: 70', Size 4"


(5) Screen: Size _____, Length _____.

(6) Were any formations sealed against pollution?
_____ yes, X no.

If YES depth of formation _____

Why _____

Drillers Remarks: _____

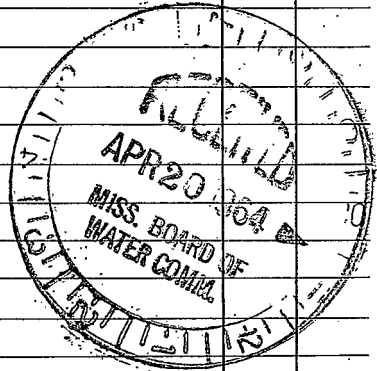

(Use Back Side)

Well No.

