

NEWTON
 S M 33
 3-68

MISSISSIPPI
 BOARD OF WATER COMMISSIONERS
 416 North-State Street
 Jackson, Mississippi 39201

WATER WELL DRILLERS LOG

3.19.68 date well completed
 McDonald + Hill firm name
 NEWTON county well located


LANDOWNER: OLIVER JENKINS
 Hickory Miss
 (mailing address)

description of fomations encountered	from to	
	from	to
CLAY	0	11
SAND	11	16
SHALE	16	55
SHALE ST ROCK	55	200
SAND	200	230

WELL LOCATION:
 sec 31 T 6 N R 13 E
 S W
 2 miles EAST of Hickory
 (distance) (direction) (nearest town)

WELL PURPOSE: HOME
 (home, irrigation, municipal, industrial)


- WELL COMPLETION DATA:
- (1) diameter (inches) 4" WELL
 - (2) total depth (feet) _____
 - (3) static water level (feet) 9' below above top of ground.
 - (4) casing PVC 50' (material) (depth)
 4" (size) if telescope see back.
 - (5) screen No No (length) (depth to top)
 No No (size) (material)
 - (6) pump 1/2 JET 10 (HP) (yield gpm)
 220 (type power)
 - (7) electric log No (yes or no)
 No (organization running log)
 - (8) how well bottom plugged OPEN

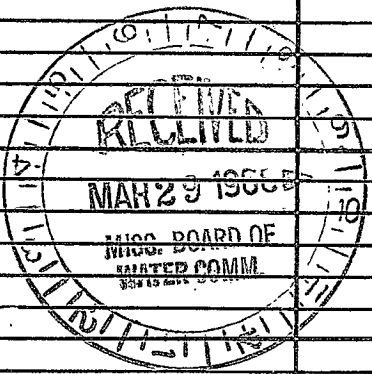

DRILLERS REMARKS:

If well telescopes please
sketch and show depths.

GROUND LEVEL

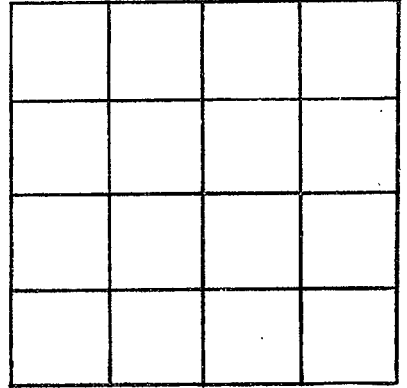

SECTION _____

Please indicate well location X.

ADDITIONAL INFORMATION

If more than one screen,
show locations of each on sketch.