

CODED

Loaded

Newton
M 35
9-20-68

MISSISSIPPI
BOARD OF WATER COMMISSIONERS
416 North State Street
Jackson, Mississippi 39201

CODED

WATER WELL DRILLERS LOG

9-20-1968 date well completed
Williamson Drilling Co firm name
Newton county well located

LANDOWNER: Darrell Hynes

description of formations encountered

from to

Chucky, Miss

top soil
blue clay
sand
green shale
sand

0 2
2 10
10 20
20 25
25 170

(mailing address)

WELL LOCATION:

sec 35 T-6 N R-13 E
inside 1 miles city of Chucky
(distance) (direction) (nearest town)

WELL PURPOSE: haul
(home, irrigation, municipal, industrial)

WELL COMPLETION DATA:

- (1) diameter (inches) 4
- (2) total depth (feet) 170
- (3) static water level (feet) 10 below top of ground. above
- (4) casing block 22
(material) (depth)
- 4 if telescope see back.
(size)
- (5) screen no
(length) (depth to top)
- (size) (material)
- (6) pump 1 4
(HP) (yield gpm)
- Elect
(type power)
- (7) electric log no
(yes or no)
- no
(organization running log)
- (8) how well bottom plugged open


DRILLERS REMARKS:

DEC 2 1968

MISS. BD. OF
WATER COMM.

If well telescopes please sketch and show depths.

GROUND LEVEL

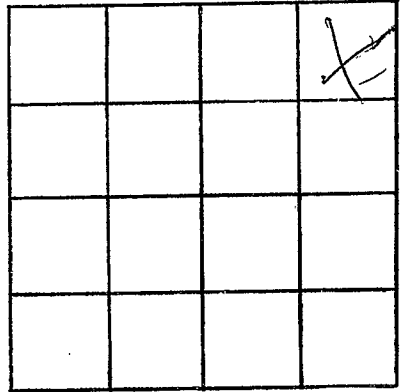

SECTION 35

Please indicate well location X.

ADDITIONAL INFORMATION

If more than one screen,
show locations of each on sketch.