

code

CODED

CODED

Newton
M 36
9-19-68

MISSISSIPPI
BOARD OF WATER COMMISSIONERS
416 North State Street
Jackson, Mississippi 39201

WATER WELL DRILLERS LOG

9-19-1968 Williamson Drilling Newton
date well completed firm name county well located

LANDOWNER: E. J. Cone
Chumby
Miss.
(mailing address)

description of formations encountered	from	to
Red Clay	0	5
Red sand	0	20
green shale	20	140
sand	140	170

WELL LOCATION:
sec 26 T. 6 N R. 13 E
3 W
1/2 mile Chumby of
(distance) (direction) (nearest town)

WELL PURPOSE: Home
(home, irrigation, municipal, industrial)


- WELL COMPLETION DATA:
- (1) diameter (inches) 4
 - (2) total depth (feet) 170
 - (3) static water level (feet) 30 below above top of ground.
 - (4) casing Black 54 (material) (depth)
 - 4 (size) if telescope see back.
 - (5) screen 20 (length) (depth to top)
 - (size) (material)
 - (6) pump 3/4 6 (HP) (yield gpm)
 - Elect (type power)
 - (7) electric log 20 (yes or no)
 - 20 (organization running log)
 - (8) how well bottom plugged open

DRILLERS REMARKS:

BEG - 5 1968
MISS. HD. OF
WATER COMMISSIONERS

If well telescopes please sketch and show depths.

GROUND LEVEL

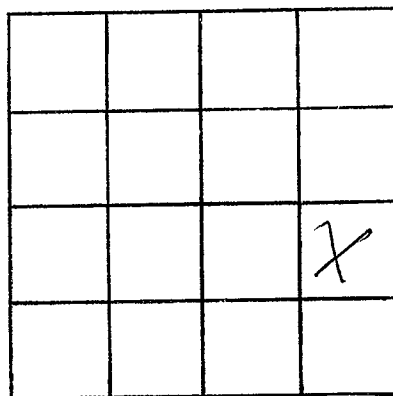

SECTION 26

Please indicate well location X.

ADDITIONAL INFORMATION

If more than one screen,
show locations of each on sketch.