

Newton
M3T
11-1-68

MISSISSIPPI
 BOARD OF WATER COMMISSIONERS
 416 North State Street
 Jackson, Mississippi 39201

CODED

WATER WELL DRILLERS LOG

11-1- data well completed 1968 Williamson Drilling Co. firm name Newton county well located

LANDOWNER: <u>Barbara Ferguson</u> <u>Chunky Miss</u> (mailing address)	description of formations encountered	from	to
	<u>Red Clay</u>	<u>0</u>	<u>4</u>
	<u>Blue Clay</u>	<u>2</u>	<u>15</u>
	<u>sand</u>	<u>15</u>	<u>25</u>
	<u>green rock</u>	<u>25</u>	<u>125</u>
	<u>soil</u>	<u>125</u>	<u>225</u>

WELL LOCATION:
 sec. 27 T. 60 N R. 13 E
1 1/2 miles W of Chunky
 (distance) (direction) (nearest town)

WELL PURPOSE: Home
 (home, irrigation, municipal, industrial)

- WELL COMPLETION DATA:
- diameter (inches) 4
 - total depth (feet) 225
 - static water level (feet) 36 (below/above top of ground)
 - casing Block (material), 31 (depth)
4 (size) if telescope see back.
 - screen no (length), (depth to top)
 (size) (material)
 - pump 3/4 (HP), 5 (yield gpm)
Elect (type power)
 - electric log no (yes or no)
no (organization running log)
 - how well bottom plugged open

CODED


JAN 28 1969

DRILLERS REMARKS:

MISS. BN. OF
 WATER COMM.

If well telescopes please sketch and show depths.

GROUND LEVEL

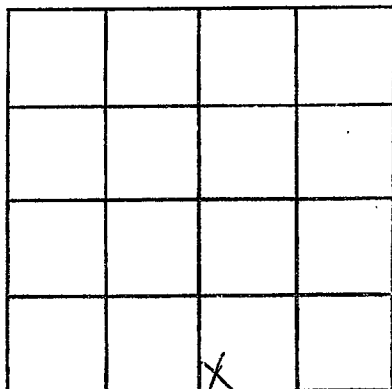

SECTION 27

Please indicate well location X.

ADDITIONAL INFORMATION

If more than one screen,
show locations of each on sketch.