

MISSISSIPPI
BOARD OF WATER COMMISSIONERS
416 North State Street
Jackson, Mississippi 39201

WATER WELL DRILLERS LOG

Newton
M 38
9-69

Sept 1969 date well completed
Wilkerson firm name
Newton county well located

LANDOWNER:

Mr L E Shirley
Hickory
(mailing address)

description of fomations encountered

from to

Sand clay 0 35
blue " 35 115
Sand + Rock 115 135
Rock 135 145
hard black clay 45 190
SAND 190 235

WELL LOCATION:

sec. 10 T. 6 N R. 13 E
S W
7 miles NE of Hickory
(distance) (direction) (nearest town)

WELL PURPOSE:

home
(home, irrigation, municipal, industrial)

WELL COMPLETION DATA:

- (1) diameter (inches) 2
- (2) total depth (feet) 235
- (3) static water level (feet) 83 below top of ground.
- (4) casing Galv. 231, (material) (depth)
- (5) screen 4, 235 (length) (depth to top)
- 2, Stainless (size) (material)
- (6) pump 1 1/2, 6 (HP) (yield gpm)
- Elec (type power)
- (7) electric log NO (yes or no)

(organization running log)

(8) how well bottom plugged 2BWL


DRILLERS REMARKS:

OCT 27 1969

MISS. BD. OF WATER COMMISSIONERS

If well telescopes please sketch and show depths.

GROUND LEVEL

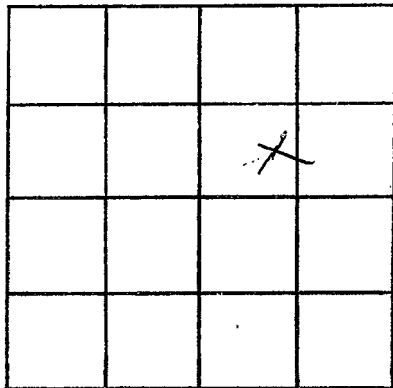

SECTION 10

Please indicate well location X.

ADDITIONAL INFORMATION

If more than one screen,
show locations of each on sketch.