

MISSISSIPPI  
BOARD OF WATER COMMISSIONERS  
416 North State Street  
Jackson, Mississippi 39201

WATER WELL DRILLERS LOG

Newton  
M 39  
9-69

Sept 1969 date well completed  
Wilkinson Drilling firm name  
Newton county well located

LANDOWNER:

Maylan Smith  
Hickory Miss  
(mailing address)

description of formations encountered

from to

SAND + clay	0	30
CLAY	30	45
hard Black. Formations	45	180
SAND	180	214

WELL LOCATION:

sec. 20 T. 6 N R. 13 E  
S W  
4 miles N.E. of Hickory  
(distance) (direction) (nearest town)

WELL PURPOSE: home  
(home, irrigation, municipal, industrial)

WELL COMPLETION DATA:

- (1) diameter (inches) 2
- (2) total depth (feet) 214
- (3) static water level (feet) 20 below above top of ground.
- (4) casing GALV, 210, (material) (depth)
- \_\_\_\_\_ If telescope see back. (size)
- (5) screen 4', 214 (length) (depth to top)
- 2, Stainless (size) (material)
- (6) pump 1, 760 P. h. (HP) (yield-gpm)
- Elec (type power)
- (7) electric log No (yes or no)
- \_\_\_\_\_ (organization running log)
- (8) how well bottom plugged 2 B.W.U.


DRILLERS REMARKS:

OCT 27 1969

MISS. Bd. of WATER COMMISSIONERS

If well telescopes please sketch and show depths.

GROUND LEVEL

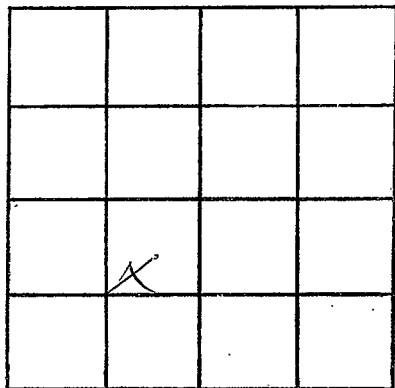

SECTION 20

Please indicate well location X.

ADDITIONAL INFORMATION

If more than one screen,  
show locations of each on sketch.