

Newton  
M 40  
7-3-69

MISSISSIPPI  
BOARD OF WATER COMMISSIONERS  
416 North State Street  
Jackson, Mississippi 39201

WATER WELL DRILLERS LOG

7-3-1969 date well completed  
William Drilling Co. firm name  
Newton county well located

LANDOWNER: J. Blount  
Hickory, Miss.  
(mailing address)

description of formations encountered	from	to
top soil	0	2
sand	2	25
blue clay	25	80
knipd red clay	80	245
sand	245	280

WELL LOCATION:  
sec 31 T 6 N R 13 E  
1/2 miles East of Hickory  
(distance) (direction) (nearest town)

WELL PURPOSE: Home  
(home, irrigation, municipal, industrial)


- WELL COMPLETION DATA:
- (1) diameter (inches) 1 1/2
  - (2) total depth (feet) 280
  - (3) static water level (feet) 20 below top of ground.
  - (4) casing black 6 7/8 (material) (depth)  
1 1/2 (size) if telescope see back.
  - (5) screen no (length) (depth to top)
  - (6) pump 3/4 (size) (material) 20 (HP) (yield gpm)  
elect. (type power)
  - (7) electric log no (yes or no)  
no (organization running log)
  - (8) how well bottom plugged open

DRILLERS REMARKS:

MISS. Bd. OF WATER COMM.

If well telescopes please sketch and show depths.

GROUND LEVEL

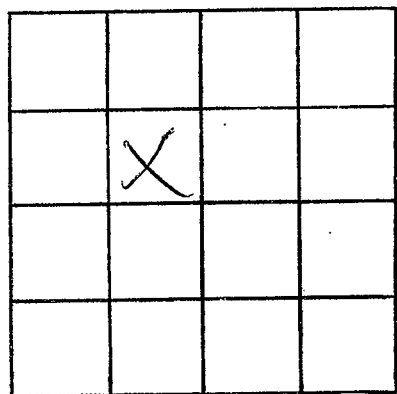

SECTION 31

Please indicate well location X.

ADDITIONAL INFORMATION

If more than one screen,  
show locations of each on sketch.