

NEWTON

M 41

11-3-69

MISSISSIPPI  
 BOARD OF WATER COMMISSIONERS  
 416 North State Street  
 Jackson, Mississippi 39201

CODED

WATER WELL DRILLERS LOG

Nov 3 1969  
date well completed

McDonalds Well Inc  
firm name

Newton  
county well located

LANDOWNER: O.C. TREST

RT 1

Hickory Miss  
(mailing address)

WELL LOCATION:

sec 19 T 6 N R 13 E  
 S W  
4 miles North of Hickory  
 (distance) (direction) (nearest town)

WELL PURPOSE: HOME  
(home, irrigation, municipal, industrial)

WELL COMPLETION DATA:

- (1) diameter (inches) 2
- (2) total depth (feet) 266
- (3) static water level (feet) 49 below top of ground.
- (4) casing 2 RTR, 261  
(material) (depth)  
no If telescope see back.  
(size)
- (5) screen 5 261  
(length) (depth to top)  
2" brass  
(size) (material)
- (6) pump 3/4 10  
(HP) (yield gpm)  
Meyers gop  
(type power)
- (7) electric log no  
(yes or no)  
no  
(organization running log)
- (8) how well bottom plugged 2" back pressure valve

description of formations encountered

from

to

Clay + sand

0 20

shell

20 66

sandy with ST Rock

66 90

of green sand

90 98

of sand

98 108

Rock + shell

108 140

ST sand

140 150

Rock + shell

150 210

ST green sand

210 230

ST coarse sand +

230 266

Brown shell

DRILLERS REMARKS:


none

NOV 12 1969

MISS. Bd. of  
WATER COMM.

If well telescopes please sketch and show depths.

GROUND LEVEL

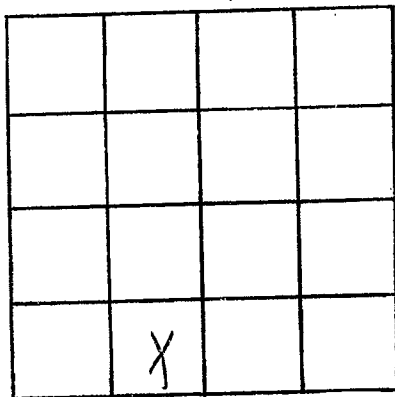

SECTION 19

Please indicate well location X.

ADDITIONAL INFORMATION

If more than one screen, show locations of each on sketch.