

Newton  
 M43  
 10-23-69

MISSISSIPPI  
 BOARD OF WATER COMMISSIONERS  
 416 North State Street  
 Jackson, Mississippi 39201

CODED

WATER WELL DRILLERS LOG

10-23 date well completed  
 1969 Williams Drilling Co. firm name  
 Newton county well located

LANDOWNER: Robert M. Houghton

Description of formations encountered

from to

from	to
0	7
7	42
42	84
84	110
110	145

At 1  
 Cherry, Miss.  
 (mailing address)

red Clay  
 blue Clay  
 sand  
 green silt clay  
 sand

WELL LOCATION:

sec. 11 T. 6 N R. 13 E  
 S W  
 5 miles N of Cherry  
 (distance) (direction) (nearest town)

WELL PURPOSE: Home  
 (home, irrigation, municipal, industrial)

WELL COMPLETION DATA:

- (1) diameter (inches) 4
- (2) total depth (feet) 145
- (3) static water level (feet) 50 below top of ground.
- (4) casing (material) black (depth) 105
- (size) if telescope see back.
- (5) screen no (length) (depth to top)
- (size) (material)
- (6) pump 3/4 (HP) 12 (yield gpm)  
 Electro (type power)
- (7) electric log no (yes or no)  
 no (organization running log)
- (8) how well bottom plugged open


NOV - 5 1970

DRILLERS REMARKS:

MISSISSIPPI  
 WATER BOARD

If well telescopes please sketch and show depths.

GROUND LEVEL

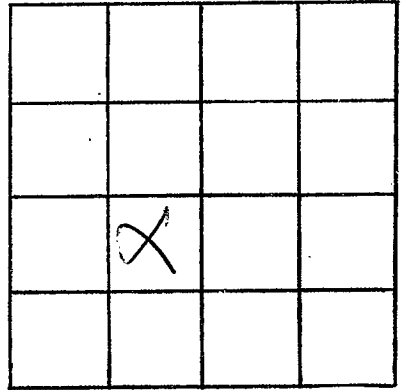

SECTION 11

Please indicate well location X.

ADDITIONAL INFORMATION

If more than one screen,  
show locations of each on sketch.