

E log # 23

Newton Co
M 45
5-20-70

MISSISSIPPI
BOARD OF WATER COMMISSIONERS
416 North State Street
Jackson, Mississippi 39201

CODED

WATER WELL DRILLERS LOG

5/20 1970 Forest Drilling Newton
date well completed firm name county well located

LANDOWNER: Town of
Chukky
Chukky, Miss.
(mailing address)

description of formations encountered	from	to
Clay	0	5
sand	5	12
Hard clay	12	17
Rock	17	19
Blue clay with strs rock	-	-
19	105	
Med sand	105	119
Shallow break clay	119	120
Med sand (good)	120	129
Hard shale	129	142
Blue clay	142	183
Shale & soft clay	183	204
Fine sand with heavy str clay	-	-
204	260	
Fine sand	260	265
Clay	265	285

WELL LOCATION:
sec. 25 T. 6 N. R. 13 E
3
- miles - of Chukky
(distance) (direction) (nearest town)

WELL PURPOSE: municipal
(home, irrigation, municipal, industrial)

WELL COMPLETION DATA:

- (1) diameter (inches) 8"
- (2) total depth (feet) 140'
- (3) static water level (feet) 14' below above top of ground.
- (4) casing Steel / 103'
(material) (depth)
8" (size) if telescope see back.
- (5) screen 25' / 105'
(length) (depth to top)
6" / Stainless Steel
(size) (material)
- (6) pump 5 / 80
(HP) (yield gpm)
Elect
(type power)
- (7) electric log yes
(yes or no)
Miss. Geological
(organization running log)
- (8) how well bottom plugged 6" Backhead
Valve

CODED


MAY 22 1970

MISS. BD. OF
WATER COMM.

DRILLERS REMARKS: 10' of 4"
Tail Pipe under screen
22' of 6" log pipe on
top of screen with
lead seal

If well telescopes please sketch and show depths.

GROUND LEVEL

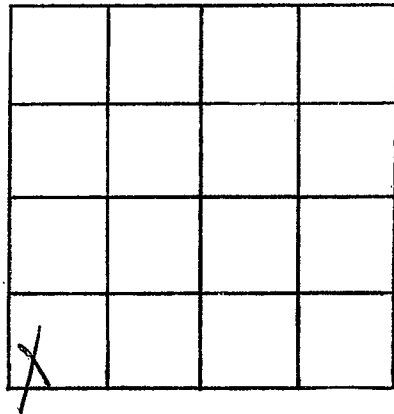

SECTION 25

Please indicate well location X.

ADDITIONAL INFORMATION

If more than one screen,
show locations of each on sketch.