

Newton
M 46
6-9-70

MISSISSIPPI
 BOARD OF WATER COMMISSIONERS
 416 North State Street
 Jackson, Mississippi 39201

CODED

WATER WELL DRILLERS LOG

6-9-1970 date well completed William Drilling Co. firm name Newton county well located

LANDOWNER: Mose Martin
Rt 1 Box 167
Hickory, Miss
 (mailing address)

description of formations encountered	from	to
<u>top soil</u>	<u>0</u>	<u>2</u>
<u>red clay</u>	<u>2</u>	<u>8</u>
<u>blue clay</u>	<u>8</u>	<u>30</u>
<u>sand</u>	<u>30</u>	<u>42</u>
<u>rock & clay</u>	<u>42</u>	<u>160</u>
<u>sand</u>	<u>160</u>	<u>195</u>

WELL LOCATION:
 sec. 5 T. 6N R. 13E
5 miles North of Hickory
 (distance) (direction) (nearest town)

WELL PURPOSE: Home
 (home, irrigation, municipal, industrial)

- WELL COMPLETION DATA:
- (1) diameter (inches) 4
 - (2) total depth (feet) 195
 - (3) static water level (feet) 70 ^{below} _{above} top of ground.
 - (4) casing Black (material), 111 (depth)
4 (size) if telescope see back.
 - (5) screen no (length), (depth to top)
 (size), (material)
 - (6) pump 1/2 (HP), 10 (yield gpm)
Elect. (type power)
 - (7) electric log no (yes or no)
no (organization running log)
 - (8) how well bottom plugged Open

CODED


JUL 14 1970

DRILLERS REMARKS:

MISS. Bd. OF
 WATER COM.

If well telescopes please sketch and show depths.

GROUND LEVEL

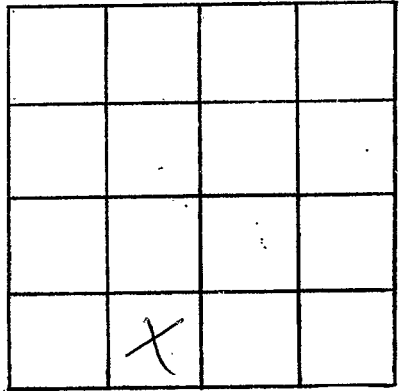

SECTION 5

Please indicate well location X.

ADDITIONAL INFORMATION

If more than one screen,
show locations of each on sketch.