

NEWTON

MISSISSIPPI BOARD OF WATER COMMISSIONERS

CODED

M 47
8-30-61

WATER WELL DRILLERS LOG

Newton

Date: 8.30, 1961, Driller: McDONALD HILL County: ~~Newton~~
(Name)

(1) Owner of Land: James CAUDILL
(Name)
Chunky-Miss R 2
(Address)
36 6013 E

(2) Location: 1/4, 1/4, Sec. T R
15 miles WEST, of MERIDIAN
(distance) (direction) (Nearest Town)

(3) Topography: X
(Hilly) (Flat) (Level)

(4) Purpose of Well: DOMESTIC
(Domestic Irrigation
Municipal, Industrial, Other)

Description & Color of Materials Sand, Clay, Red Clay, Shell, etc.	Thick- ness Feet	Depth Feet
SAND	0	23
SOFT SANDY SHALE	23	42
BROWN SHALE	42	60
SHELLS ST ROCK	60	73
ROCK	73	74
SHELLS ST SAND	74	85
SOFT GRAY SHALE	85	95
BLUE SHALE	95	120
SHALE ST ROCK	120	150
SANDY SHALE STRUCK	150	200
SAND	200	250

Information upon completion of well:

(1) Diameter 4" inches.

(2) Total Depth 250' feet.

(3) Water Level 98' feet below top of ground.

(4) Cased to 147', Size 4"


(5) Screen: Size _____, Length _____

(6) Were any formations sealed against pollution?
_____ yes, X no.

CODED

If YES depth of formation _____
Why _____

Drillers Remarks: _____

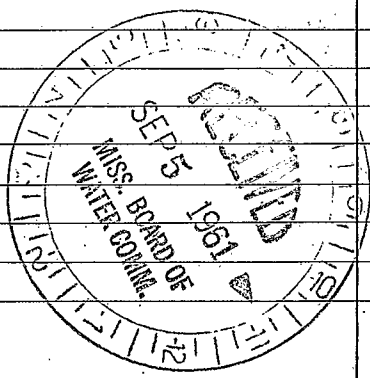

(Use Back Side)

Well No.

