

NEWTON
M 48
2-28-71

MISSISSIPPI
 BOARD OF WATER COMMISSIONERS
 416 North State Street
 Jackson, Mississippi 39201

CODED

WATER WELL DRILLERS LOG

2-28- 1971 Williamson Drilling Co. Newton
 date well completed firm name county well located

LANDOWNER: <u>Jimmie Alexander</u>	description of formations encountered	from	to
<u>Chumby, Miss.</u>			
	<u>red clay</u>	<u>0</u>	<u>6</u>
	<u>blue clay</u>	<u>6</u>	<u>38</u>
	<u>rock + clay</u>	<u>38</u>	<u>140</u>
	<u>sand</u>	<u>140</u>	<u>195</u>

(mailing address)

WELL LOCATION:
 sec 25 T 6 N R 13 E
1/2 miles N of Chumby
 (distance) (direction) (nearest town)

WELL PURPOSE: Home
 (home, irrigation, municipal, industrial)

- WELL COMPLETION DATA:
- (1) diameter (inches) 4
 - (2) total depth (feet) 195
 - (3) static water level (feet) 70 below above top of ground.
 - (4) casing Black metal 128
 (material) (depth)
4 if telescope see back.
 (size)
 - (5) screen no
 (length) (depth to top)
 (size) (material)
 - (6) pump 3/4 12
 (HP) (yield gpm)
Elect.
 (type power)
 - (7) electric log no
 (yes or no)
no
 (organization running log)
 - (8) how well bottom plugged Open

CODED


MAR 20 1971

MISS. BD. OF
 WATER COMM.

DRILLERS REMARKS:

If well telescopes please sketch and show depths.

GROUND LEVEL

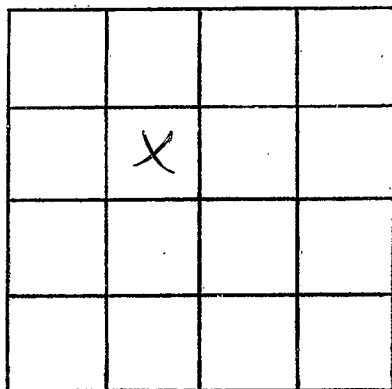

SECTION 25

Please indicate well location X.

ADDITIONAL INFORMATION

If more than one screen,
show locations of each on sketch.