

NEWTON

M 49

7-10-67

MISSISSIPPI
 BOARD OF WATER COMMISSIONERS
 416 North State Street
 Jackson, Mississippi 39201

CODED

WATER WELL DRILLERS LOG

7-10

date well completed

1967 Ernest Dilling

firm name

Newton

county well located

LANDOWNER: J. R. McQueen

Stone

Hickory, Miss.
(mailing address)

WELL LOCATION:

sec. 18 T. 6 N. R. 13 E.
 S. W.

3 1/2 miles North of Hickory
 (distance) (direction) (nearest town)

WELL PURPOSE: Home
 (home, irrigation, municipal, industrial)

WELL COMPLETION DATA:

- (1) diameter (inches) 2"
- (2) total depth (feet) 265
- (3) static water level (feet) 66 below above top of ground.
- (4) casing Galv., 255,
(material) (depth)
- _____ if telescope see back.
(size)
- (5) screen 10 ft, 25 ft.
(length) (depth to top)
- 2", Cm. Brass
(size) (material)
- (6) pump 3 HP, see 2 PH.
(HP) (yield gpm)
- Elect.
(type power)
- (7) electric log no.
(yes or no)
- _____ (organization running log)
- (8) how well bottom plugged Backwash
Relief


description of formations encountered

from

to

Clay + Red Sand	0	20
Sand	20	31
Clay	31	87
Rock + Shell	87	113
Clay	113	122
Clay + Rock	122	143
Clay + Shell + Rock	143	230
Rock	230	245
Sand	245	265

CODED

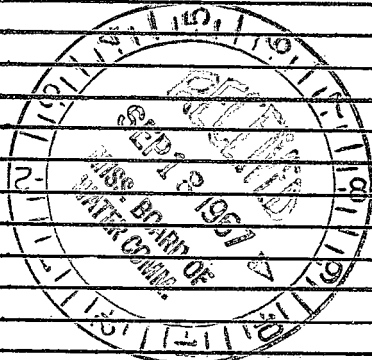

DRILLERS REMARKS:

