

Newton
M51
7-29-72

MISSISSIPPI
 BOARD OF WATER COMMISSIONERS
 416 North State Street
 Jackson, Mississippi 39201

CODED

WATER WELL DRILLERS LOG

7-29 date well completed 1972 U. L. Shelch firm name Newton county well located

LANDOWNER:
Mr. J. Logan
Shubby, Miss
 (mailing address)

description of formations encountered	from	to
	<u>Red clay</u>	<u>0</u>
<u>Sandy clay</u>	<u>20</u>	<u>35</u>
<u>Blue</u>	<u>35</u>	<u>120</u>
<u>Blue rocky</u>	<u>120</u>	<u>165</u>
<u>Sand</u>	<u>165</u>	<u>200</u>

WELL LOCATION:
 sec. 7 T. 4 N. R. 13 E.
1 miles W of Shubby
 (distance) (direction) (nearest town)

WELL PURPOSE: Home
 (home, irrigation, municipal, industrial)

- WELL COMPLETION DATA:
- (1) diameter (inches) 2
 - (2) total depth (feet) 200
 - (3) static water level (feet) 59 below top of ground
 - (4) casing Gal Steel 125
 (material) (depth)
 - _____ If telescope see back.
 (size)
 - (5) screen _____
 (length) (depth to top)
 - _____ (size) _____ (material)
 - (6) pump 1 400
 (HP) (yield gpm)
 - elec
 (type power)
 - (7) electric log _____
 (yes or no)
 - _____ (organization running log)
 - (8) how well bottom plugged _____

CODED


JUL 31 1972

DRILLERS REMARKS:
Open Hole

MISS. BD. OF
 WATER COMM

If well telescopes please sketch and show depths.

GROUND LEVEL

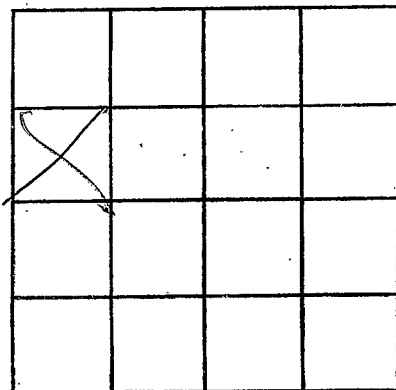

SECTION _____

Please indicate well location X.

ADDITIONAL INFORMATION

If more than one screen,
show locations of each on sketch.