

Newton
M 52
5-18-72

MISSISSIPPI
 BOARD OF WATER COMMISSIONERS
 416 North State Street
 Jackson, Mississippi 39201

CODED

WATER WELL DRILLERS LOG

5-18- 1972 Wilson Drilling Newton
 date well completed firm name county well located

LANDOWNER: Mr. F. Henley
Chumby
Ms.
 (mailing address)

description of formations encountered	from	to
<u>red clay</u>	<u>0</u>	<u>8</u>
<u>red sand</u>	<u>8</u>	<u>18</u>
<u>Blue Clay & Rock</u>	<u>18</u>	<u>170</u>
<u>sand</u>	<u>170</u>	<u>195</u>

WELL LOCATION:
 sec 13 T 60 N R 13 E
2 miles North of Chumby
 (distance) (direction) (nearest town)

WELL PURPOSE: Home
 (home, irrigation, municipal, industrial)

WELL COMPLETION DATA:

(1) diameter (inches) 4

(2) total depth (feet) 195

(3) static water level (feet) 130 below / above top of ground.

(4) casing metal 160
 (material) (depth)

4 if telescope see back.
 (size)

(5) screen no
 (length) (depth to top)

(size) (material)

(6) pump 3/4 12
 (HP) (yield gpm)

Elect
 (type power)

(7) electric log no
 (yes or no)

no
 (organization running log)

(8) how well bottom plugged Open

CODED


DEC 29 1972

DRILLERS REMARKS:

MISS. BD. OF
 WATER COMM.

If well telescopes please sketch and show depths.

GROUND LEVEL

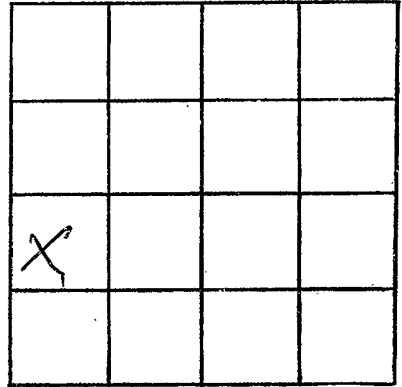

SECTION 13

Please indicate well location X.

ADDITIONAL INFORMATION

If more than one screen,
show locations of each on sketch.