

Newton
M 54
3-23-73

MISSISSIPPI
BOARD OF WATER COMMISSIONERS
416 North State Street
Jackson, Mississippi 39201

CODF

WATER WELL DRILLERS LOG

3.23.73 19 McDONALD & SONS NEWTON
date well completed firm name county well located

LANDOWNER:
A. T. EMBREY
RD 1 CHUNKY
(mailing address)

WELL LOCATION:
sec 27 6N R. 13E
1 1/2 miles WEST of CHUNKY
(distance) (direction) (nearest town)

WELL PURPOSE: HOME
(home, irrigation, municipal, industrial)

- WELL COMPLETION DATA:
- (1) diameter (inches) 4"
 - (2) total depth (feet) 200'
 - (3) static water level (feet) 57' below top of ground.
 - (4) casing 4" PVC 85'
(material) (depth)
4" if telescope see back.
(size)
 - (5) screen _____
(length) (depth to top)

(size) (material)
 - (6) pump 1 JET 10
(HP) (yield gpm)
220
(type power)
 - (7) electric log _____
(yes or no)

(organization running log)
 - (8) how well bottom plugged OPEN

description of formations encountered	from	to
<u>CLAY</u>	<u>0</u>	<u>12</u>
<u>SAND ST CLAY</u>	<u>12</u>	<u>38</u>
<u>MEL SHALE</u>	<u>38</u>	<u>87</u>
<u>ROCK HARD SHALE</u>	<u>87</u>	<u>165</u>
<u>WHITE SAND</u>	<u>165</u>	<u>200</u>


CODED

DRILLERS REMARKS:

MAR 27 1973

If well telescopes please sketch and show depths.

GROUND LEVEL

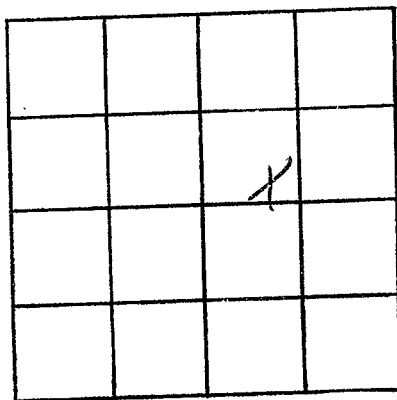

SECTION _____

Please indicate well location X.

ADDITIONAL INFORMATION

If more than one screen,
show locations of each on sketch.