

Newton
M55
3-26-73

MISSISSIPPI
BOARD OF WATER COMMISSIONERS
416 North State Street
Jackson, Mississippi 39201

WATER WELL DRILLERS LOG

CODED
NEWTON

3.26.73
date well completed

McDonald + Hill
firm name

NEWTON
county well located

LANDOWNER:

C. L. GROVES

description of formations encountered

CLAY

from 0 to 10

Chunky MISS
(mailing address)

ROCK ST SHALE

10 95

WELL LOCATION:

sec 14 T 6 N R 13 W
3 1/2 miles NORTH of Chunky
(distance) (direction) (nearest town)

SHALE

95 114

SANDY

114 120

WHITE SAND

120 140

WELL PURPOSE:

HOME
(home, irrigation, municipal, industrial)

CODED

140 150

WELL COMPLETION DATA:

- (1) diameter (inches) 4"
- (2) total depth (feet) 150'
- (3) static water level (feet) 57' below top of ground.
- (4) casing pvc 103'
(material) (depth)
4" if telescope see back.
(size)
- (5) screen _____
(length) (depth to top)

(size) (material)
- (6) pump 1/2 10
(HP) (yield gpm)
220
(type power)
- (7) electric log _____
(yes or no)


(organization running log)
- (8) how well bottom plugged OPEN

DRILLERS REMARKS:

3-26-73

If well telescopes please
sketch and show depths.

GROUND LEVEL

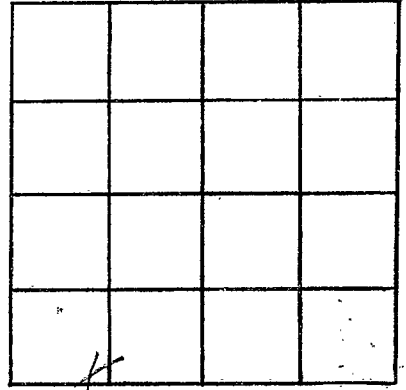

SECTION _____

Please indicate well location X.

ADDITIONAL INFORMATION

If more than one screen,
show locations of each on sketch.