

MISSISSIPPI
BOARD OF WATER COMMISSIONERS
416 North State Street
Jackson, Mississippi 39201

CODED

WATER WELL DRILLERS LOG

Newton
M 56
6-18-73

6-18-73
date well completed

McDonald + Hill
firm name

Newton
county well located

LANDOWNER:
JAMES IVEY
Hickory Miss
(mailing address)

description of formations encountered	from	to
<u>Clay</u>	<u>0</u>	<u>28</u>
<u>Sand Clay</u>	<u>28</u>	<u>110</u>
<u>Soft Shale</u>	<u>110</u>	<u>120</u>
<u>Shale</u>	<u>120</u>	<u>150</u>
<u>Rock ST. Shale</u>	<u>150</u>	<u>180</u>
<u>R Sand</u>	<u>180</u>	<u>200</u>
<u>ROCK ST SHALE</u>	<u>200</u>	<u>320</u>
<u>SAND</u>	<u>320</u>	<u>340</u>

WELL LOCATION:
sec 30 T 6 N R 13 E
S W
2 miles NORTH of Hickory
(distance) (direction) (nearest town)

WELL PURPOSE: HOME
(home, irrigation, municipal, industrial)

WELL COMPLETION DATA:

(1) diameter (inches) 4 1/2

(2) total depth (feet) 340

(3) static water level (feet) 72 below top of ground.

(4) casing pre 150'
(material) (depth)
4"
(size) If telescope see back.

(5) screen _____
(length) (depth to top)
(size) (material)

(6) pump 1/2 Sub 10
(HP) (yield gpm)
220
(type power)

(7) electric log _____
(yes or no)
(organization running log)

(8) how well bottom plugged OPEN


CODED

JUN 23 1973

DRILLERS REMARKS:

If well telescopes please sketch and show depths.

GROUND LEVEL

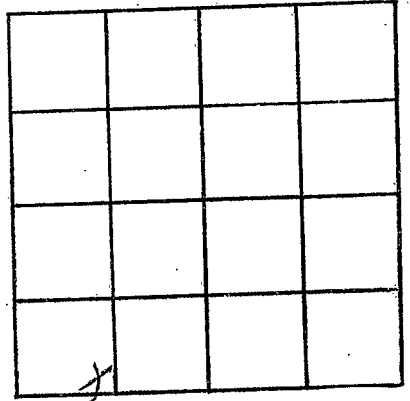

SECTION _____

Please indicate well location X.

ADDITIONAL INFORMATION

If more than one screen,
show locations of each on sketch.