

NEWTON
M 51
8-1-73

MISSISSIPPI
BOARD OF WATER COMMISSIONERS
416 North State Street
Jackson, Mississippi 39201

CODED

WATER WELL DRILLERS LOG

8-1-73 date well completed
McDonald & Hill firm name
NEWTON county well located


LANDOWNER:	description of fomations encountered	from	to
CLIFF Moulds	CLAY	0	10
Hickory (mailing address)	SAND	10	30
WELL LOCATION:	SHALE	30	60
sec. 30 T. 16N R. 13E S	ROCK ST SHALE	60	80
1 miles EAST of HICKORY (distance) (direction) (nearest town)	ROCK ST SAND	80	100
WELL PURPOSE: HOME (home, irrigation, municipal, industrial)	SHALE	100	118
WELL COMPLETION DATA:	SHALE ST ROCK	118	220
(1) diameter (inches) 4"	SAND	220	2100
(2) total depth (feet) 260'			
(3) static water level (feet) 23' below top of ground.			
(4) casing PVC 115' (material) (depth) 4" If telescope see back. (size)			
(5) screen (length) (depth to top) (size) (material)			
(6) pump 1/2 sub 18 (HP) (yield gpm) 920 (type power)			
(7) electric log (yes or no) (organization running log)			
(8) how well bottom plugged OPEN			
DRILLERS REMARKS:			

CODED

AUG 3 1973

If well telescopes please
sketch and show depths.

GROUND LEVEL

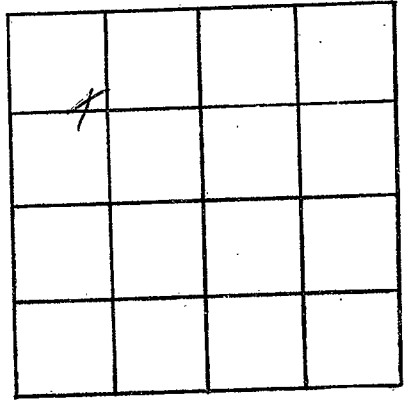

SECTION _____

Please indicate well location X.

ADDITIONAL INFORMATION

If more than one screen,
show locations of each on sketch.