

NEWTON

M 59

8-13-73

MISSISSIPPI BOARD OF WATER COMMISSIONERS 416 North State Street Jackson, Mississippi 39201

CODED

WATER WELL DRILLERS LOG

8-13

date well completed

1973

W. D. Welch Newton

firm name

county well located

LANDOWNER: W.R. Boyette

description of formations encountered

from

to

Chumbly

red clay

0 25

Miss

rock + shell

25 40

(mailing address)

WELL LOCATION:

sec. 27 T-20 N R-4 E

1 6 S 13

1 miles W of Chumbly

(distance)

(direction)

(nearest town)

blue rock

40 170

blue

170 220

WELL PURPOSE:

(home, irrigation, municipal, industrial)

WELL COMPLETION DATA:

(1) diameter (inches) 2"

(2) total depth (feet) 220

(3) static water level (feet) 34 below above top of ground.

(4) casing 2" gal steel (material) (depth)

(size) if telescope see back.

(5) screen Open Hole (length) (depth to top)

(size) (material)

(6) pump (HP) (yield gpm)

(type power)

(7) electric log (yes or no)

(organization running log)

(8) how well bottom plugged

CODED

SEP 11 1973


MISS. BD. OF WATER COMMISSIONERS

DRILLERS REMARKS:

He plans on just pump later

If well telescopes please sketch and show depths.

GROUND LEVEL

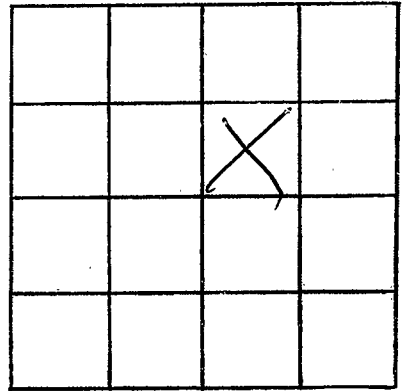

SECTION _____

Please indicate well location X.

ADDITIONAL INFORMATION

If more than one screen;
show locations of each on sketch.