

**NEWTON**  
**M 60**  
**16-1-73**

MISSISSIPPI  
 BOARD OF WATER COMMISSIONERS  
 416 North State Street  
 Jackson, Mississippi 39201

**CODED 73**

**WATER WELL DRILLERS LOG**

MISS. 67

10.1.73  
 date well completed

MCDONALD HILL  
 firm name

NEWTON  
 county well located

LANDOWNER:  
JAMES PEARSON  
Chunky  
 (mailing address)

description of formations encountered	from	to
CLAY SAND	0	14
15' M.I.F.	14	25
ROCK ST SAND	25	50
SHALE ST ROCK	50	115
ROCK ST SHALE	115	180
SAND	180	220

WELL LOCATION:  
 sec. 22 T 4N R 13E  
2 miles N. WEST of Chunky  
 (distance) (direction) (nearest town)

WELL PURPOSE: HOME  
 (home, irrigation, municipal, industrial)


- WELL COMPLETION DATA:
- (1) diameter (inches) 4"
  - (2) total depth (feet) 220
  - (3) static water level (feet) 70' below top of ground.
  - (4) casing PVC, 110'  
 (material) (depth)  
4"  
 (size) if telescope see back.
  - (5) screen \_\_\_\_\_  
 (length) (depth to top)  
 (size) (material)
  - (6) pump 34 10  
 (HP) (yield gpm)  
ELECTRIC  
 (type power)
  - (7) electric log \_\_\_\_\_  
 (yes or no)  
 (organization running log)
  - (8) how well bottom plugged OPEN

**CODED**

DRILLERS REMARKS: \_\_\_\_\_

If well telescopes please sketch and show depths.

GROUND LEVEL

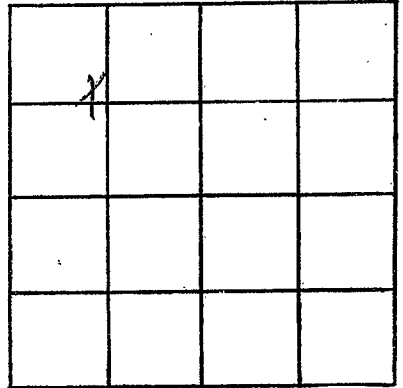

SECTION \_\_\_\_\_

Please indicate well location X.

ADDITIONAL INFORMATION

If more than one screen, show locations of each on sketch.