

NEWTON
M 62
10-2-73

MISSISSIPPI
BOARD OF WATER COMMISSIONERS
416 North State Street
Jackson, Mississippi 39201

CODED

WATER WELL DRILLERS LOG

10.2.73 date well completed
McDONALD + HILL firm name
NEWTON county well located

LANDOWNER:
Phillip Gandy
Chunky Miss
(mailing address)

description of formations encountered	from	to
CLAY	0	14
land to Clay	14	40
Shale to Roll	40	98
Rock to Shale	98	170
land	170	200

WELL LOCATION:
sec 27 T 60N R 13E
S W
1.4 miles WEST of CHUNKY
(distance) (direction) (nearest town)

WELL PURPOSE: HOME
(home, irrigation, municipal, industrial)


- WELL COMPLETION DATA:
- (1) diameter (inches) 4.1
 - (2) total depth (feet) 200'
 - (3) static water level (feet) 55' below top of ground.
 - (4) casing PVC, 92' (material) (depth)
4" (size) if telescope see back.
 - (5) screen (length) (depth to top)
(size) (material)
 - (6) pump 1/2 sub 10 (HP) (yield gpm)
ELECTRIC (type power)
 - (7) electric log (yes or no)
(organization running log)
 - (8) how well bottom plugged OPEN

CODED

DRILLERS REMARKS: TIME 5:30

If well telescopes please sketch and show depths.

GROUND LEVEL

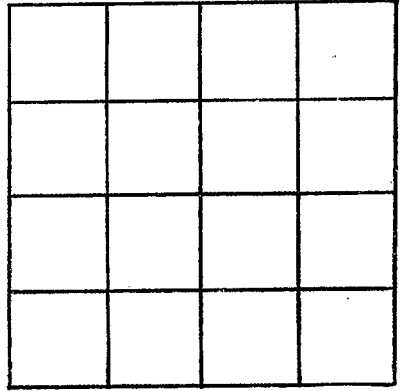

SECTION _____

Please indicate well location X.

ADDITIONAL INFORMATION

If more than one screen,
show locations of each on sketch.