

NEWTON  
M 63  
11-2-73

MISSISSIPPI  
BOARD OF WATER COMMISSIONERS  
416 North State Street  
Jackson, Mississippi 39201

CODED

WATER WELL DRILLERS LOG

11-2-73 date well completed 1973 J. L. Welch firm name Newton county well located

LANDOWNER: H B May

Shubby miss

(mailing address)

WELL LOCATION:

sec. 14 T. 4 N. R. 13 E

1/4 miles NW of Shubby (distance) (direction) (nearest town)

WELL PURPOSE: home (home, irrigation, municipal, industrial)

WELL COMPLETION DATA:

- (1) diameter (inches) 3 1/2
- (2) total depth (feet) 200
- (3) static water level (feet) 91 below top of ground
- (4) casing (material) 1 1/2" (depth) 147
- (5) screen (size) none (length) (depth to top)
- (6) pump (HP) 1/2 (yield gpm) 250 (type power) electric
- (7) electric log (yes or no)
- (8) how well bottom plugged

description of formations encountered	from	to
Red clay	0	24
Blue	24	80
Blue rocky	80	160
Blue + sandy	160	170
Sand	170	200

CODED

DEC 6 1973


DRILLERS REMARKS:

Open Hole

MISS. BD OF WATER COMMISSIONERS

If well telescopes please sketch and show depths.

GROUND LEVEL

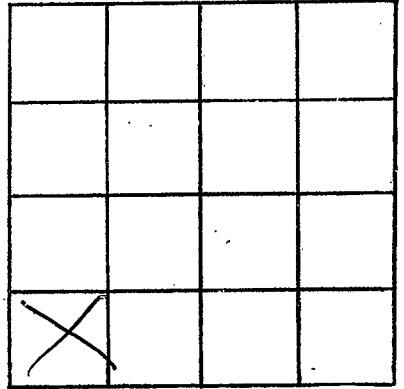

SECTION \_\_\_\_\_

Please indicate well location X.

ADDITIONAL INFORMATION

If more than one screen,  
show locations of each on sketch.