

NEWTON
M64
5-24-73

MISSISSIPPI
BOARD OF WATER COMMISSIONERS
416 North State Street
Jackson, Mississippi 39201

CODER

WATER WELL DRILLERS LOG

5-24 1973 Tony Drilling & Newton
date well completed firm name county well located

LANDOWNER:
Mrs. Mollie McGee
Chunky, Miss.
(mailing address)

description of formations encountered	from	to
<u>yellow clay</u>	<u>0</u>	<u>20</u>
<u>topsoil sand</u>	<u>20</u>	<u>40</u>
<u>blue clay & rock</u>	<u>40</u>	<u>200</u>
<u>sand & rock</u>	<u>200</u>	<u>225</u>

WELL LOCATION:
sec 29 T 6 N R 13E
4 miles W of Chunky
(distance) (direction) (nearest town)

CODER

WELL PURPOSE:
(home) irrigation, municipal, industrial

- WELL COMPLETION DATA:
- (1) diameter (inches) 4"
 - (2) total depth (feet) 225
 - (3) static water level (feet) 60 below/above top of ground.
 - (4) casing steel 200'
(material) (depth)
2" if telescope see back.
(size)
 - (5) screen 15' 270'
(length) (depth to top)
2" Stanley
(size) (material)
 - (6) pump 3/4 10
(HP) (yield gpm)
sub.
(type power)
 - (7) electric log
(yes or no)


(organization running log)
 - (8) how well bottom plugged wash barrel

DRILLERS REMARKS:

DEC 5 1973

If well telescopes please sketch and show depths.

GROUND LEVEL

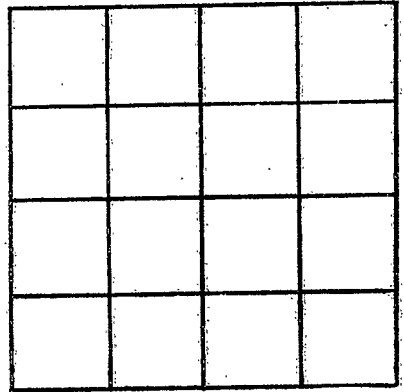

SECTION _____

Please indicate well location X.

ADDITIONAL INFORMATION

If more than one screen,
show locations of each on sketch.