

NEWTON
M 65
10-6-73

MISSISSIPPI
 BOARD OF WATER COMMISSIONERS
 416 North State Street
 Jackson, Mississippi 39201

CODED

WATER WELL DRILLERS LOG


10-6-73 date well completed Williamson Drilling Co. firm name Newton county well located

LANDOWNER: <u>Robert Blesley</u> <u>Chunky Mrs.</u>	description of formations encountered	from	to
(mailing address)	<u>top soil</u>	<u>0</u>	<u>3</u>
WELL LOCATION: sec. <u>27 T 60 N</u> R. <u>13 E</u> <u>2</u> miles <u>West</u> of <u>Chunky</u> (distance) (direction) (nearest town)	<u>Blue Clay</u>	<u>3</u>	<u>35</u>
WELL PURPOSE: <u>Home</u> (home, irrigation, municipal, industrial)	<u>sand</u>	<u>35</u>	<u>43</u>
WELL COMPLETION DATA:	<u>rock & clay</u>	<u>43</u>	<u>180</u>
(1) diameter (inches) <u>4</u>	<u>sand</u>	<u>180</u>	<u>210</u>
(2) total depth (feet) <u>210</u>			
(3) static water level (feet) <u>20</u> <input checked="" type="checkbox"/> below <input type="checkbox"/> above top of ground.			
(4) casing <u>plastic</u> , <u>84</u> (material) (depth)			
<u>4</u> (size) If telescope see back.			
(5) screen <u>no</u> (length) (depth to top)			
(size) (material)			
(6) pump <u>1</u> <u>10</u> (HP) (yield gpm)			
<u>Elect</u> (type power)			
(7) electric log <u>no</u> (yes or no)			
<u>no</u> (organization running log)			
(8) how well bottom plugged <u>Open</u>			
DRILLERS REMARKS:			

CODED

If well telescopes please sketch and show depths.

GROUND LEVEL

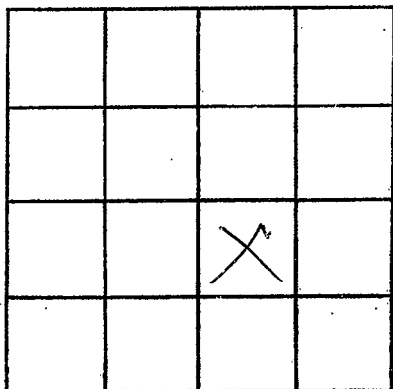

SECTION 27

Please indicate well location X.

ADDITIONAL INFORMATION

If more than one screen, show locations of each on sketch.