

NEWTON

M 68

5-20-74

MISSISSIPPI BOARD OF WATER COMMISSIONERS
416 North State Street
Jackson, Mississippi 39201

CODED

WATER WELL DRILLERS LOG

5, 20, 74
date well completed

McDONALD & HILL
firm name

NEWTON
county well located

LANDOWNER:

C.C. CORNELIUS

Chunky Miss
(mailing address)

description of formations encountered

from

to

CLAY	0	18
CLAY ST SAND	18	40
SHALE	40	90
G SAND ST ROCK	90	118
SHALE ST ROCK	118	155
ROCK ST SHALE	155	218
SHALE	218	240
SAND	240	260

WELL LOCATION:

sec. 15 T-10 S R-13 E
2 miles NORTH of Chunky
(distance) (direction) (nearest town)

WELL PURPOSE:

HOME
(home, irrigation, municipal, industrial)

WELL COMPLETION DATA:

- (1) diameter (inches) 4"
- (2) total depth (feet) 260'
- (3) static water level (feet) 145' below top of ground.
- (4) casing PVC 152' (material) (depth)
4" (size) if telescope see back.
- (5) screen (length) (depth to top)
(size) (material)
- (6) pump 1/2 sub 10 (HP) (yield gpm)
E (type power)
- (7) electric log (yes or no)
(organization running log)
- (8) how well bottom plugged OPEN


CODED

DRILLERS REMARKS:

MISS. BD. OF WATER COMMISSIONERS
MAY 28 1974

If well telescopes please sketch and show depths.

GROUND LEVEL

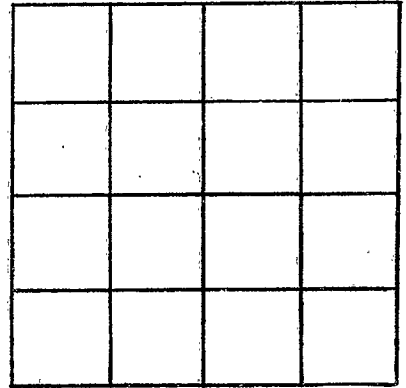

SECTION _____

Please indicate well location X.

ADDITIONAL INFORMATION

If more than one screen,
show locations of each on sketch.