

NEWTON
M69
7-10-74

MISSISSIPPI BOARD OF WATER COMMISSIONERS CODED
 416 North State Street
 Jackson, Mississippi 39201

WATER WELL DRILLERS LOG

7. 10. 74 19 McDONALD + HILL NEWTON
 date well completed firm name county well located

LANDOWNER:
A. D. ESTES
Hickory Miss
 (mailing address)

WELL LOCATION:
 sec 24 T 6 (N) R 13 (E)
2 miles NORTH of Hickory
 (distance) (direction) (nearest town)

WELL PURPOSE: HOME
 (home, irrigation, municipal, industrial)

- WELL COMPLETION DATA:**
- (1) diameter (inches) 4"
 - (2) total depth (feet) 500'
 - (3) static water level (feet) 100' below top of ground.
 - (4) casing PVC 100'
 (material) (depth)
4"
 (size) if telescope see back.
 - (5) screen _____
 (length) (depth to top)

 (size) (material)
 - (6) pump 1/2 sub 10
 (HP) (yield gpm)
ELECTRIC
 (type power)
 - (7) electric log _____
 (yes or no)

 (organization running log)
 - (8) how well bottom plugged OPEN

description of formations encountered	from	to
clay	0	20
Sand + Clay	20	45
Shale	45	105
Rock Shale	105	130
Sand	130	150
Shale + Rock	150	270
Sand	270	300

CODED


DISCONTINUED
JUL 16 1974

MISS. BD. OF WATER COM

DRILLERS REMARKS:

If well telescopes please sketch and show depths.

GROUND LEVEL

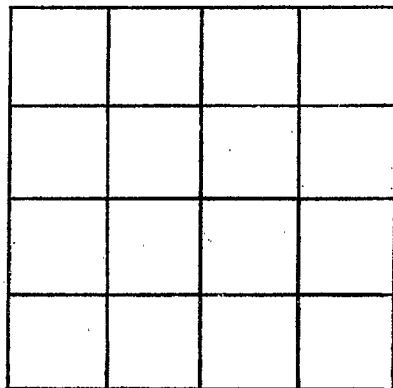

SECTION _____

Please indicate well location X.

ADDITIONAL INFORMATION

If more than one screen, show locations of each on sketch.