

MISSISSIPPI
BOARD OF WATER COMMISSIONERS
416 North State Street
Jackson, Mississippi 39201

CODED

WATER WELL DRILLERS LOG

NEWTON
M 71
10-30-74

10-30-74 date well completed
McDONALD HILL firm name
NEWTON county well located

LANDOWNER:
C.H. PUGH
Rt 1, Chunky
(mailing address)

WELL LOCATION:
sec. 11 T. 60 S. R. 13 E.
4 miles NORTH of Chunky
(distance) (direction) (nearest town)

WELL PURPOSE: HOME
(home, irrigation, municipal, industrial)

- WELL COMPLETION DATA:
- (1) diameter (inches) 4"
 - (2) total depth (feet) 250'
 - (3) static water level (feet) 169' below top of ground.
 - (4) casing PVC 185' (material) (depth)
4" (size) If telescope see back.
 - (5) screen (length) (depth to top)
(size) (material)
 - (6) pump 34 sub 6 (HP) (yield gpm)
E (type power)
 - (7) electric log (yes or no)
(organization running log)
 - (8) how well bottom plugged OPEN


description of formations encountered	from	to
SAND	0	54
SHALE	54	60
ROCK ST SHALE	60	82
ROCK ST GREEN SAND	82	90
ROCK ST SHALE	90	192
SAND	192	200
SAND	200	255

RECORDED
NOV - 4 1974
MISS. BD. OF WATER COMM.

DRILLERS REMARKS:

If well telescopes please sketch and show depths.

GROUND LEVEL

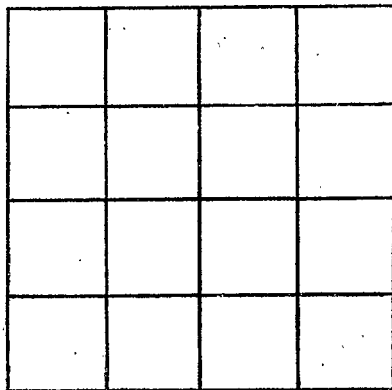

SECTION _____

Please indicate well location X.

ADDITIONAL INFORMATION

If more than one screen,
show locations of each on sketch.