

NEWTON
MT3
2-28-75

MISSISSIPPI
BOARD OF WATER COMMISSIONERS
 416 North State Street
 Jackson, Mississippi 39201

WATER WELL DRILLERS LOG

CODED

2-28-75 date well completed McDONALD + HILL firm name NEWTON county well located

LANDOWNER:
R.C. BROWN
PH 2 DECATUR
 (mailing address)

WELL LOCATION:
 sec. 18 T. 6 N. R. 13 E
5 1/2 miles NORTH of HICKORY
 (distance) (direction) (nearest town)

WELL PURPOSE: HOME
 (home, irrigation, municipal, industrial)

- WELL COMPLETION DATA:**
- (1) diameter (inches) 4"
 - (2) total depth (feet) 340'
 - (3) static water level (feet) 120' below top of ground.
 - (4) casing PVC 1 1/2"
 (material) (depth)
4" If telescope see back.
 (size)
 - (5) screen _____
 (length) (depth to top)
 (size) (material)
 - (6) pump 1/2 sub
 (HP) (yield gpm)
ELECTRIC
 (type power)
 - (7) electric log _____
 (yes or no)
 (organization running log)
 - (8) how well bottom plugged OPEN


description of formations encountered	from	to
<u>CLAY SAND</u>	<u>0</u>	<u>16</u>
<u>SAND</u>	<u>16</u>	<u>75</u>
<u>SOFT SHALE</u>	<u>75</u>	<u>95</u>
<u>MED SHALE</u>	<u>95</u>	<u>118</u>
<u>ROCK SHALE</u>	<u>118</u>	<u>130</u>
<u>GREEN SAND STRUCK</u>	<u>130</u>	<u>154</u>
<u>ROCK ST SHALE</u>	<u>154</u>	<u>270</u>
<u>SHALE</u>	<u>270</u>	<u>295</u>
<u>SAND ST SHALE</u>	<u>295</u>	<u>340</u>
CODED		
RECEIVED		
MAR - 6 1975		

DRILLERS REMARKS:
SET PUMP 140'

MISS. RD. OF WATER COMMISSIONERS

If well telescopes please sketch and show depths.

GROUND LEVEL

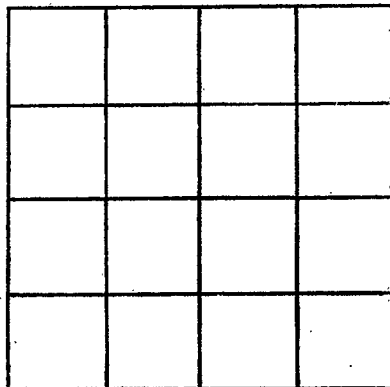

SECTION _____

Please indicate well location X.

ADDITIONAL INFORMATION

If more than one screen,
show locations of each on sketch.