

**NEWTON**  
**M 74**  
**4-24-75**

MISSISSIPPI  
 BOARD OF WATER COMMISSIONERS  
 416 North State Street  
 Jackson, Mississippi 39201 **CODED**

**WATER WELL DRILLERS LOG**

4.24.75 19 McDONALD & HILL NEWTON  
 date well completed firm name county well located

LANDOWNER:	description of formations encountered	from	to
MT PLEASANT BAPTIST CHURCH	CHURCH	0	0
RT #1, Hickory, MS (mailing address)	SAND ST PLYG	0	40
WELL LOCATION: sec 16 T 6 N R 13 E S E 3 1/2 miles North of Chunky (distance) (direction) (nearest town)	SHALE	40	74
WELL PURPOSE: CHURCH (home, irrigation, municipal, industrial)	ROCK ST SHALE	74	90
WELL COMPLETION DATA: (1) diameter (inches) 4 1/2	PRE CODED ST ROCK	90	135
(2) total depth (feet) 250'	1 ROCK ST SHALE	135	215
(3) static water level (feet) 135' below top of ground.	SAND	215	250
(4) casing PVC 70' (material) (depth) 4 1/2" If telescope see back. (size)			
(5) screen (length) (depth to top) (size) (material)			
(6) pump 1/2 Sub 10 (HP) (yield gpm) Electric (type power)			
(7) electric log (yes or no)			
(organization running log)			
(8) how well bottom plugged OPEN			
DRILLERS REMARKS:			


**DECEMBER**

APR 29 1975

MISS. Bd. OF WATER COMMISSIONERS

If well telescopes please sketch and show depths.

GROUND LEVEL

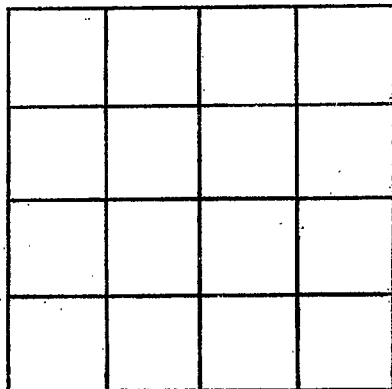

SECTION \_\_\_\_\_

Please indicate well location X.

ADDITIONAL INFORMATION

If more than one screen, show locations of each on sketch.