

CODED

NEWTON
M 75
4-25-75

MISSISSIPPI
BOARD OF WATER COMMISSIONERS
416 North State Street
Jackson, Mississippi 39201

WATER WELL DRILLERS LOG

4-25-75 19 McDONALD & HILL 008 NEWTON
date well completed firm name county well located

LANDOWNER: Gary J. Jansen
Rt #1
Hilltop, Miss.
(mailing address)

WELL LOCATION:
sec. 16 T 2N R 13E
3 miles North of Chucky
(distance) (direction) (nearest town)

WELL PURPOSE: HOME
(home, irrigation, municipal, industrial)

- WELL COMPLETION DATA:
- (1) diameter (inches) 4"
 - (2) total depth (feet) 220'
 - (3) static water level (feet) 85' below top of ground.
 - (4) casing PVC, 106'
(material) (depth)
4" if telescope see back.
(size)
 - (5) screen _____
(length) (depth to top)
(size) (material)
 - (6) pump 1 JET 5
(HP) (yield gpm)
ELECTRIC
(type power)
 - (7) electric log _____
(yes or no)
(organization running log)
 - (8) how well bottom plugged OPEN


description of formations encountered	from	to
CLAY SAND	0	25
SHALE	25	38
ROCK STR. SHALE SANDS	38	100
SHALE STR. ROCK	100	90
SANDY	90	98
SHALE	98	110
ROCK STR. SAND	110	190
SAND	190	220

RECEIVED
MAY - 2 1975
MISS. BD. OF WATER COMMISSIONERS

DRILLERS REMARKS:

If well telescopes please sketch and show depths.

GROUND LEVEL

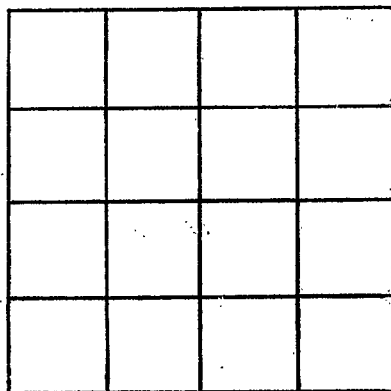

SECTION _____

Please indicate well location X.

ADDITIONAL INFORMATION

If more than one screen, show locations of each on sketch.