

M 76  
 Newton  
 1/21/75

MISSISSIPPI  
 BOARD OF WATER COMMISSIONERS  
 416 North State Street  
 Jackson, Mississippi 39201

CODED

WATER WELL DRILLERS LOG

1-21-75 date well completed  
 19 Williams Drilling Co. firm name  
 Newton county well located

LANDOWNER: Miss Jingle  
Chubbys ms.  
 (mailing address)

description of fomations encountered	from	to
top soil	0	2
Blue Clay	9	14
rock & clay	78	155
sand	155	180

WELL LOCATION:  
 sec. 14 T. 60 N. R. 13 E.  
3 miles North of Chubbys  
 (distance) (direction) (nearest town)

WELL PURPOSE: Home  
 (home, irrigation, municipal, industrial)

CODED


- WELL COMPLETION DATA:
- (1) diameter (inches) 4
  - (2) total depth (feet) 180
  - (3) static water level (feet) 95  below  above top of ground.
  - (4) casing PVC, 149,  
 (material) (depth)  
1/2 if telescope see back.  
 (size)
  - (5) screen no,  
 (length) (depth to top)  
 (size) (material)
  - (6) pump 1/2, 8  
 (HP) (yield gpm)  
Elect.  
 (type power)
  - (7) electric log no  
 (yes or no)  
no  
 (organization running log)
  - (8) how well bottom plugged open

DRILLERS REMARKS:

REGISTERED  
 JUN 5 1975  
 MISS. Bd. OF WATER COMM

If well telescopes please sketch and show depths.

GROUND LEVEL

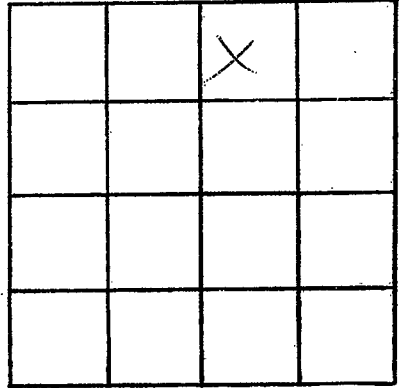

SECTION 14

Please indicate well location X.

ADDITIONAL INFORMATION

If more than one screen, show locations of each on sketch.