

M 77  
 Newton  
 5/16/75


MISSISSIPPI  
 BOARD OF WATER COMMISSIONERS  
 416 North State Street  
 Jackson, Mississippi 39201

CODED

WATER WELL DRILLERS LOG

5.16.75 19 McDonald + Hill NEWTON  
 date well completed firm name county well located


LANDOWNER:	description of formations encountered	from	to
DONALD FITZGERALD	CLAY x	0	35
Rt 11, Chunks, MS (mailing address)	SAND		
	SHALE	35	50
WELL LOCATION: sec. 12 T 6 N R 13 E 3 miles NORTH of Chunks (distance) (direction) (nearest town)	ROCK SHALE	50	74
	ST GREEN SAND	74	91
	Rock		
WELL PURPOSE: LEONARD (home, irrigation, municipal, industrial)	CODED SHALE	91	190
WELL COMPLETION DATA:	COURSE SAND	190	240
(1) diameter (inches) 4"			
(2) total depth (feet) 240			
(3) static water level (feet) 140' below top of ground.			
(4) casing PVC 45' (material) (depth) 4" (size) if telescope see back.			
(5) screen (length) (depth to top) (size) (material)			
(6) pump 1/2 sub 6 (HP) (yield gpm) ELECTRIC (type power)			
(7) electric log (yes or no)			
(organization running log)			
(8) how well bottom plugged OPEN			
DRILLERS REMARKS:			

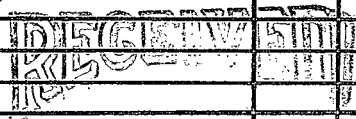

MAY 27 1975

If well telescopes please sketch and show depths.

GROUND LEVEL

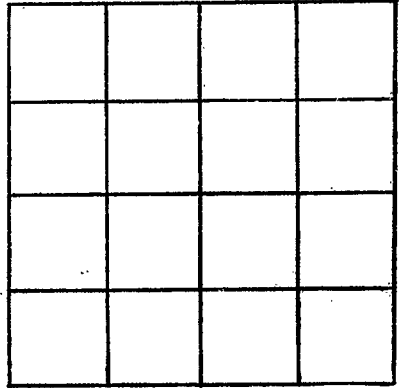

SECTION \_\_\_\_\_

Please indicate well location X.

ADDITIONAL INFORMATION

If more than one screen, show locations of each on sketch.