

Newton
M 2001
12-12-75

MISSISSIPPI
 BOARD OF WATER COMMISSIONERS
 416 North State Street
 Jackson, Mississippi 39201

WATER WELL DRILLERS LOG


12-12-75 19 MC DONALD & SONS NEWTON
 date well completed firm name county well located

LANDOWNER:	description of formations encountered	from	to
<u>T. C. McGETT</u>	<u>Clay</u>	<u>8</u>	<u>6</u>
<u>Hickory</u> (mailing address)	<u>Sand</u>	<u>10</u>	<u>8</u>
WELL LOCATION: sec. <u>30</u> T. <u>10N</u> R. <u>13E</u> S. W.	<u>Sand</u>	<u>8</u>	<u>18</u>
<u>1</u> miles <u>EAST</u> of <u>Hickory</u> (distance) (direction) (nearest town)	<u>Sand</u>	<u>18</u>	<u>45</u>
WELL PURPOSE: (home, irrigation, municipal, industrial)	<u>Sand with shells</u>	<u>45</u>	<u>90</u>
WELL COMPLETION DATA:			
(1) diameter (inches) <u>4"</u>			
(2) total depth (feet) <u>90'</u>			
(3) static water level (feet) <u>10'</u> below top of ground.			
(4) casing <u>DN</u> <u>22'</u> (material) (depth) <u>4"</u> If telescope see back. <u>SCH 160</u> (size)			
(5) screen _____ (length) (depth to top) (size) (material)			
(6) pump <u>HAND PUMP</u> (HP) (yield gpm) (type power)			
(7) electric log _____ (yes or no) (organization running log)			
(8) how well bottom plugged <u>OPEN</u>			
DRILLERS REMARKS:			

MISSISSIPPI BOARD OF WATER COMMISSIONERS
 DEC 22 1975
 MISS. BD OF WATER COM.

If well telescopes please sketch and show depths.

GROUND LEVEL

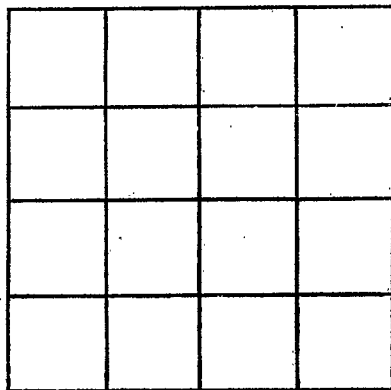

SECTION _____

Please indicate well location X.

ADDITIONAL INFORMATION

If more than one screen,
show locations of each on sketch.